

FINAL PROOF MAP


FOR TRANSFER T-12032
JAMES & SUE GILMOUR

TOWNSHIP 27 SOUTH, RANGE 34 EAST, SECTION 5, W.M.
TAX LOT: 601

RECEIVED

APR 05 2018

OWRD

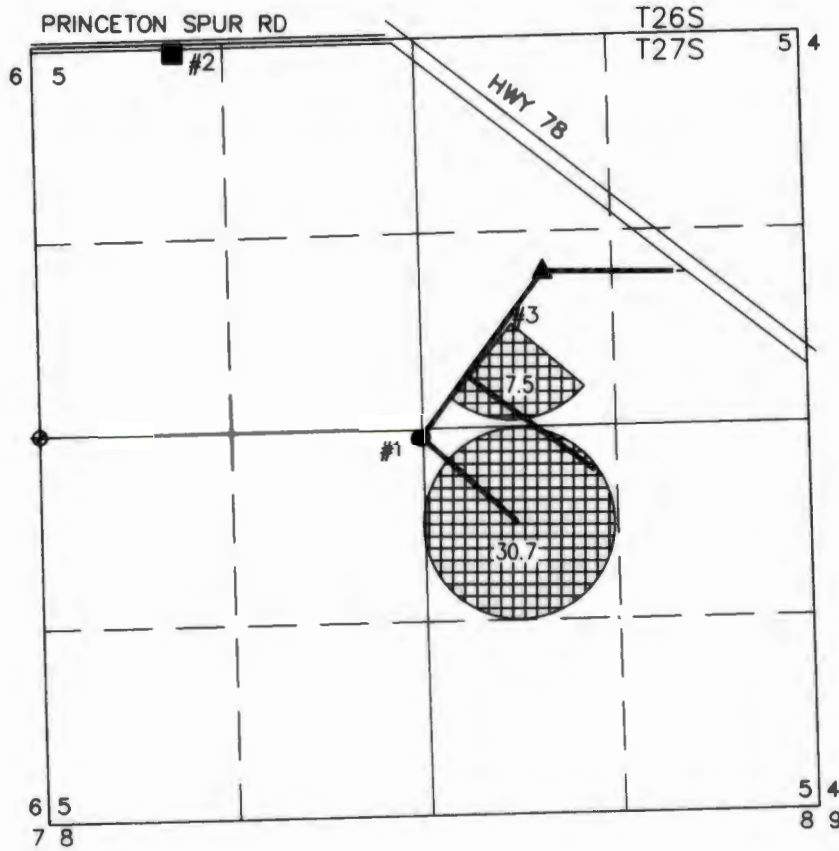

RENEWAL DATE: 12/31/2018



38.2 ACRES WATER RIGHTS FROM
WELLS 1 & 3, AS SHOWN.

◆ 3-1/2" ALUMINUM CAPPED SECTION MONUMENT

WELL 1 (HARN 1489)

● LOCATED IN THE NW 1/4 SE 1/4 SECTION 5, T27S
R34E, W.M. AND 2724 FEET SOUTH AND 2644 FEET
EAST FROM THE NW CORNER OF SECTION 5. FLOW
METER LOCATED 4' SOUTH OF WELL.

THIS MAP IS FOR THE PURPOSE OF LOCATING A WATER
RIGHT ONLY AND HAS NO INTENT TO PROVIDE LEGAL
DIMENSIONS OR THE LOCATION OF PROPERTY LINES

WELL 2 (HARN 50318)

■ LOCATED IN THE NW 1/4 NW 1/4 SECTION 5, T27S
R34E, W.M. AND 35 FEET SOUTH AND 975 FEET EAST
FROM THE NW CORNER OF SECTION 5. FLOW METER
LOCATED 6.5' SOUTHEAST FROM WELL.

WELL 3 (HARN 52056)

▲ LOCATED IN THE SW 1/4 NE 1/4 SECTION 5, T27S
R34E, W.M. AND 1138 FEET NORTH AND 3447 FEET
EAST FROM THE W 1/4 CORNER OF SECTION 5. FLOW
METER LOCATED 6' NORTHWEST FROM WELL.

PREPARED FOR:

JAMES & SUE GILMOUR
30427 STELLMACHER DRIVE
ALBANY, OR 97321

PREPARED BY:



ALL POINTS ENGINEERING AND SURVEYING, INC.
P.O. BOX 767 TERREBONNE, OR 97760
(541) 548-5833 www.APEandS.com