


T.14S. R.6W. W.M.

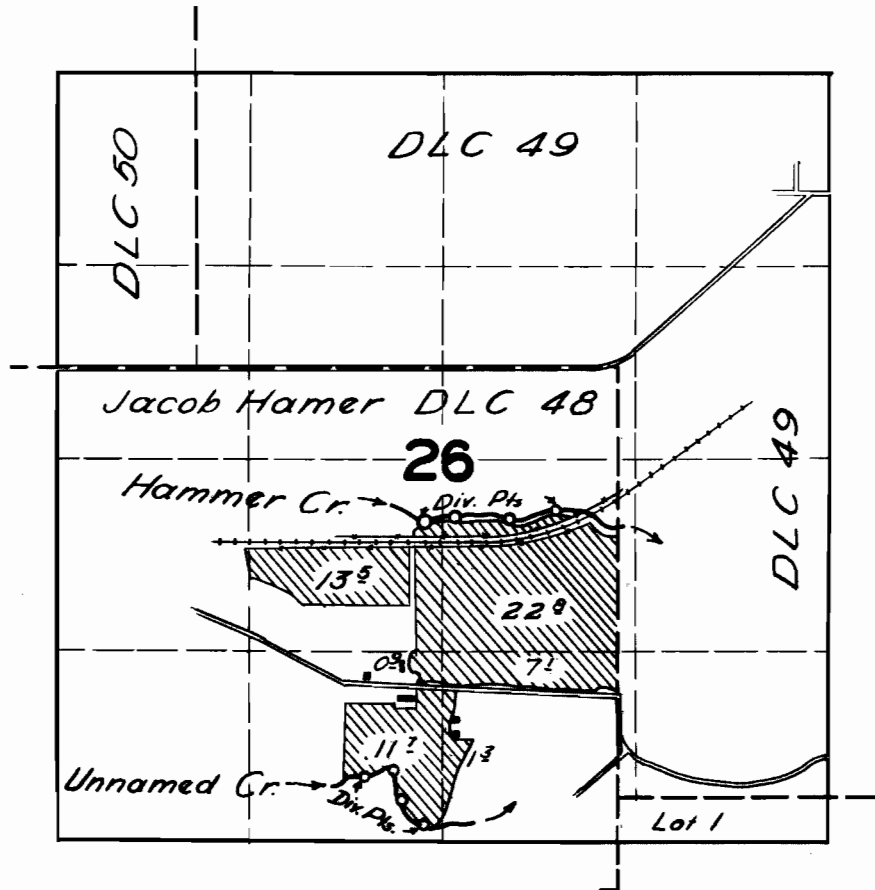

FINAL PROOF SURVEY

UNDER


Application No. 25958 Permit No. 20350

IN NAME OF

J. E. LARKIN

Surveyed 22 Apr. 1957, by [Signature]

Alpine Farm - Spies Real Estate Group LLC Transfer Application

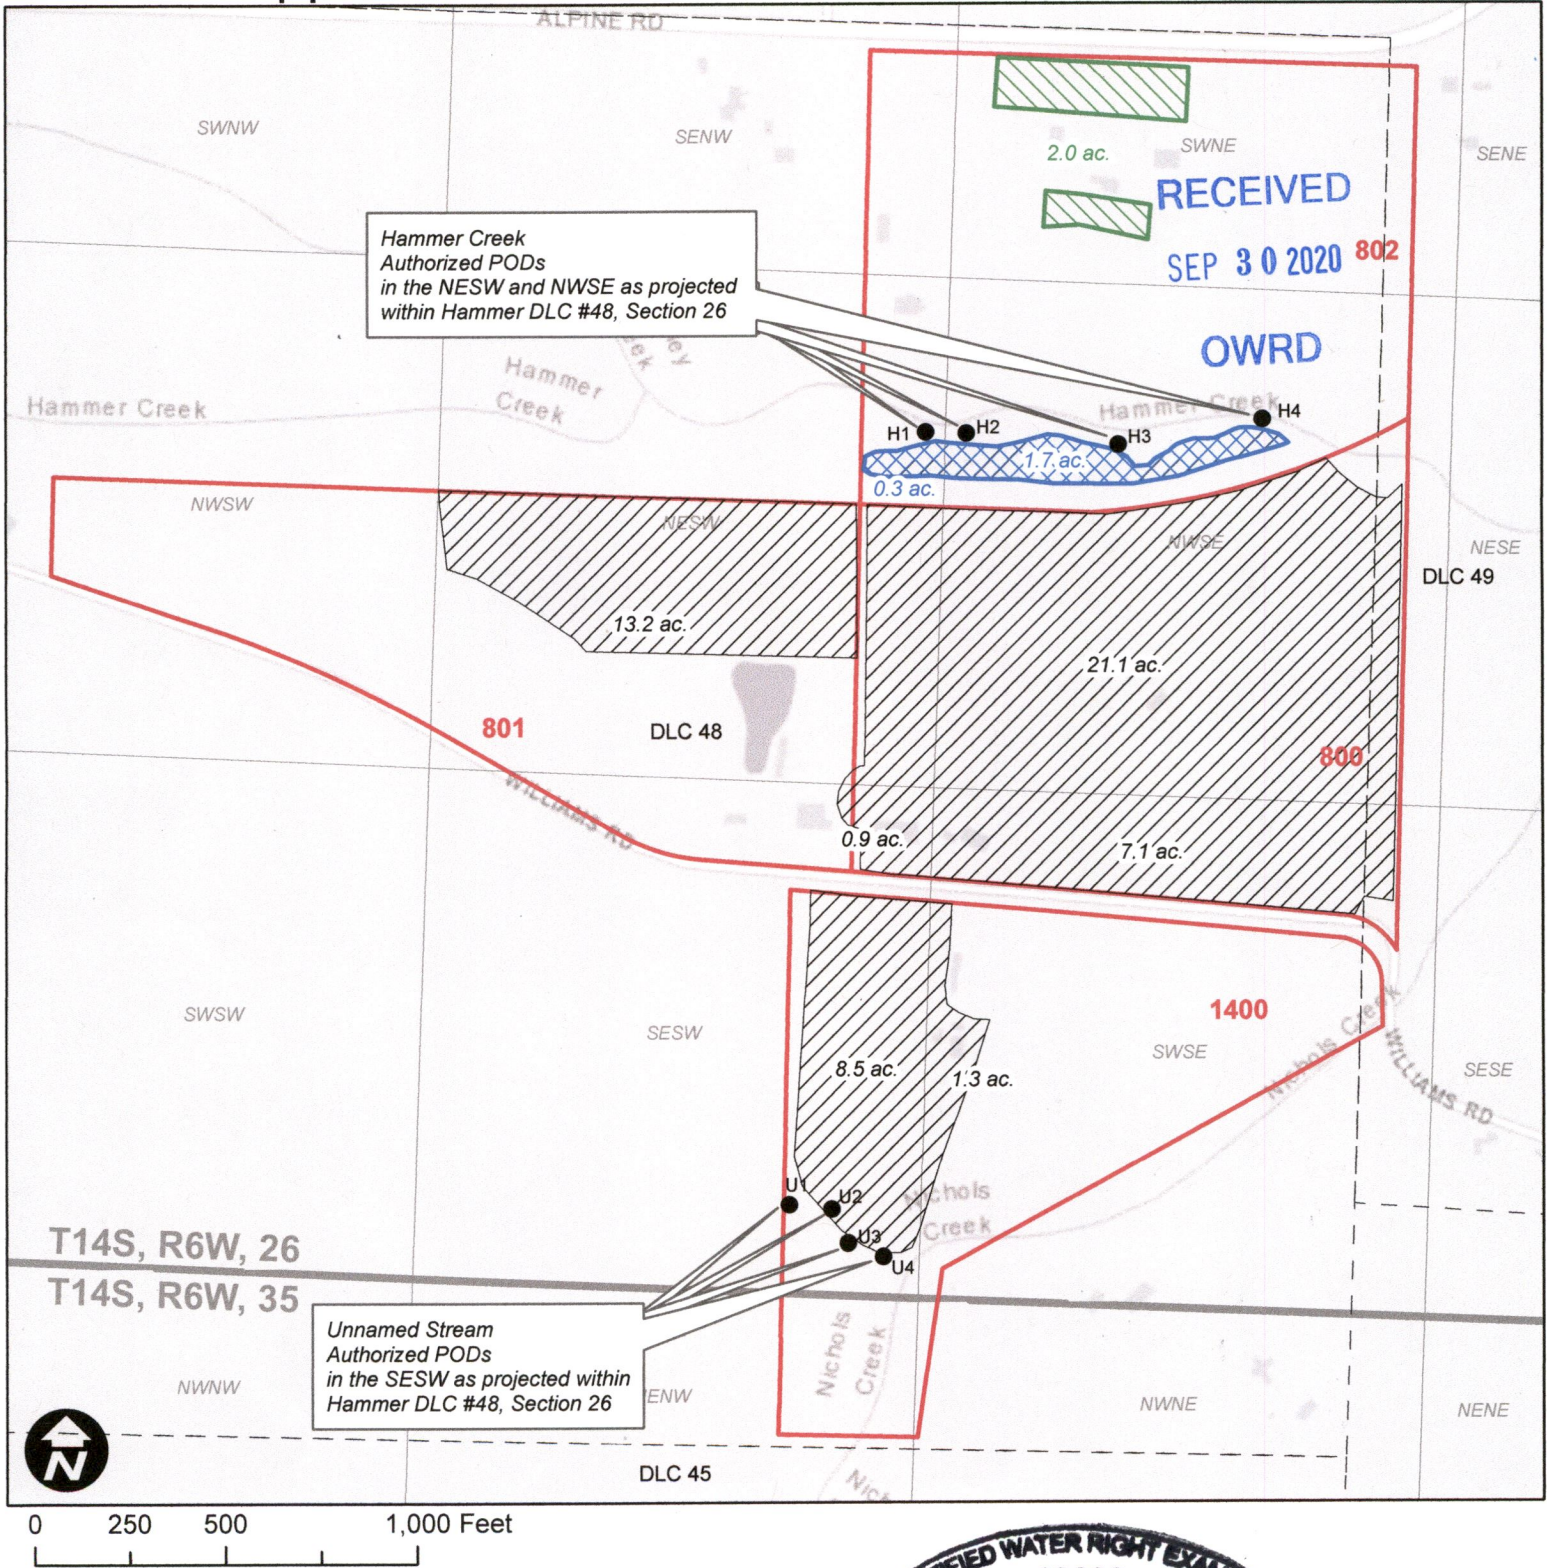

Hammer Creek
Authorized PODs
in the NESW and NWSE as projected
within Hammer DLC #48, Section 26

Unnamed Stream
Authorized PODs
in the SESW as projected within
Hammer DLC #48, Section 26

RECEIVED
SEP 30 2020 802

CERTIFIED WATER RIGHT EXAMINER
30680
William E. McGill
WILLIAM E. MCGILL
MAY 3, 2011
STATE OF OREGON

EXPIRES: 12/31/2020

- Legend**
- Cert. 24311 Transfer From
 - Cert. 24311 Transfer To
 - Cert. 24311 No Change
 - Tax Lot
 - DLC