


FINAL PROOF MAP
(PERMIT # G 12680)
FOR DARRELL & JUDITH BARNES
LOCATED IN SECTION 24, T. 18 S., R. 13 E.,
W.M., DESCHUTES COUNTY, OREGON

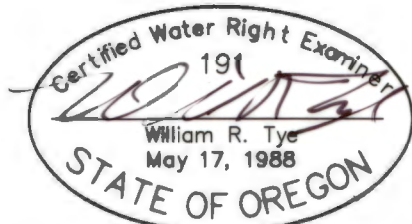

RENEWAL: JUNE 30, 2004

I, WILLIAM R. TYE, CERTIFIED WATER RIGHT EXAMINER IN THE STATE OF OREGON, HEREBY CERTIFY THE ABOVE FINAL PROOF MAP WAS PREPARED UNDER MY DIRECT SUPERVISION.


THE PREPARATION OF THIS MAP IS FOR THE PURPOSE OF IDENTIFYING THE LOCATION OF THE WATER RIGHT ONLY AND HAS NO INTENT TO PROVIDE DIMENSIONS OR LOCATIONS OF PROPERTY OWNERSHIP LINES.

RECEIVED

SEP 16 2002


**WATER RESOURCES DEPT.
SALEM, OREGON**

EXISTING WELL - NORTH
783 FEET AND EAST 1522
FEET FROM THE SW
CORNER OF SECTION 24

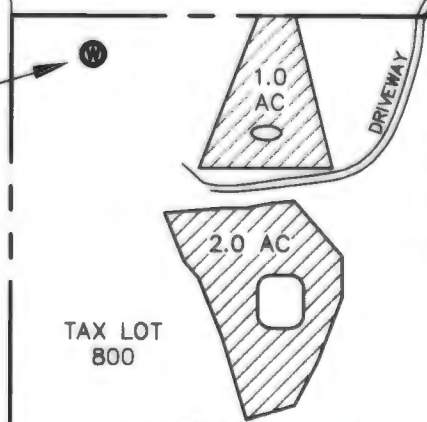

1"=400'

HIGHWAY 20

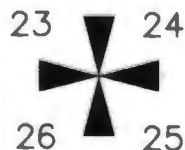

TYE ENGINEERING, INC.

725 NW HILL, BEND, OREGON 97701 (541) 389-6959

DATE: JULY 30, 2002

SCALE: 1"=400'

DRAWN BY: P.A.T.

DWG #: 951-22