



CLAIM of BENEFICIAL USE

FOR: DALE HOLLAND


BY: NATHAN R. REED, P.E., CWRE

SECTIONS 16 & 21, T24S, R4W, W.M. DOUGLAS COUNTY
TRANSFER NO. T-11729

DATE OF SURVEY: AUGUST 1, 2017



SCALE: 1" = 400'

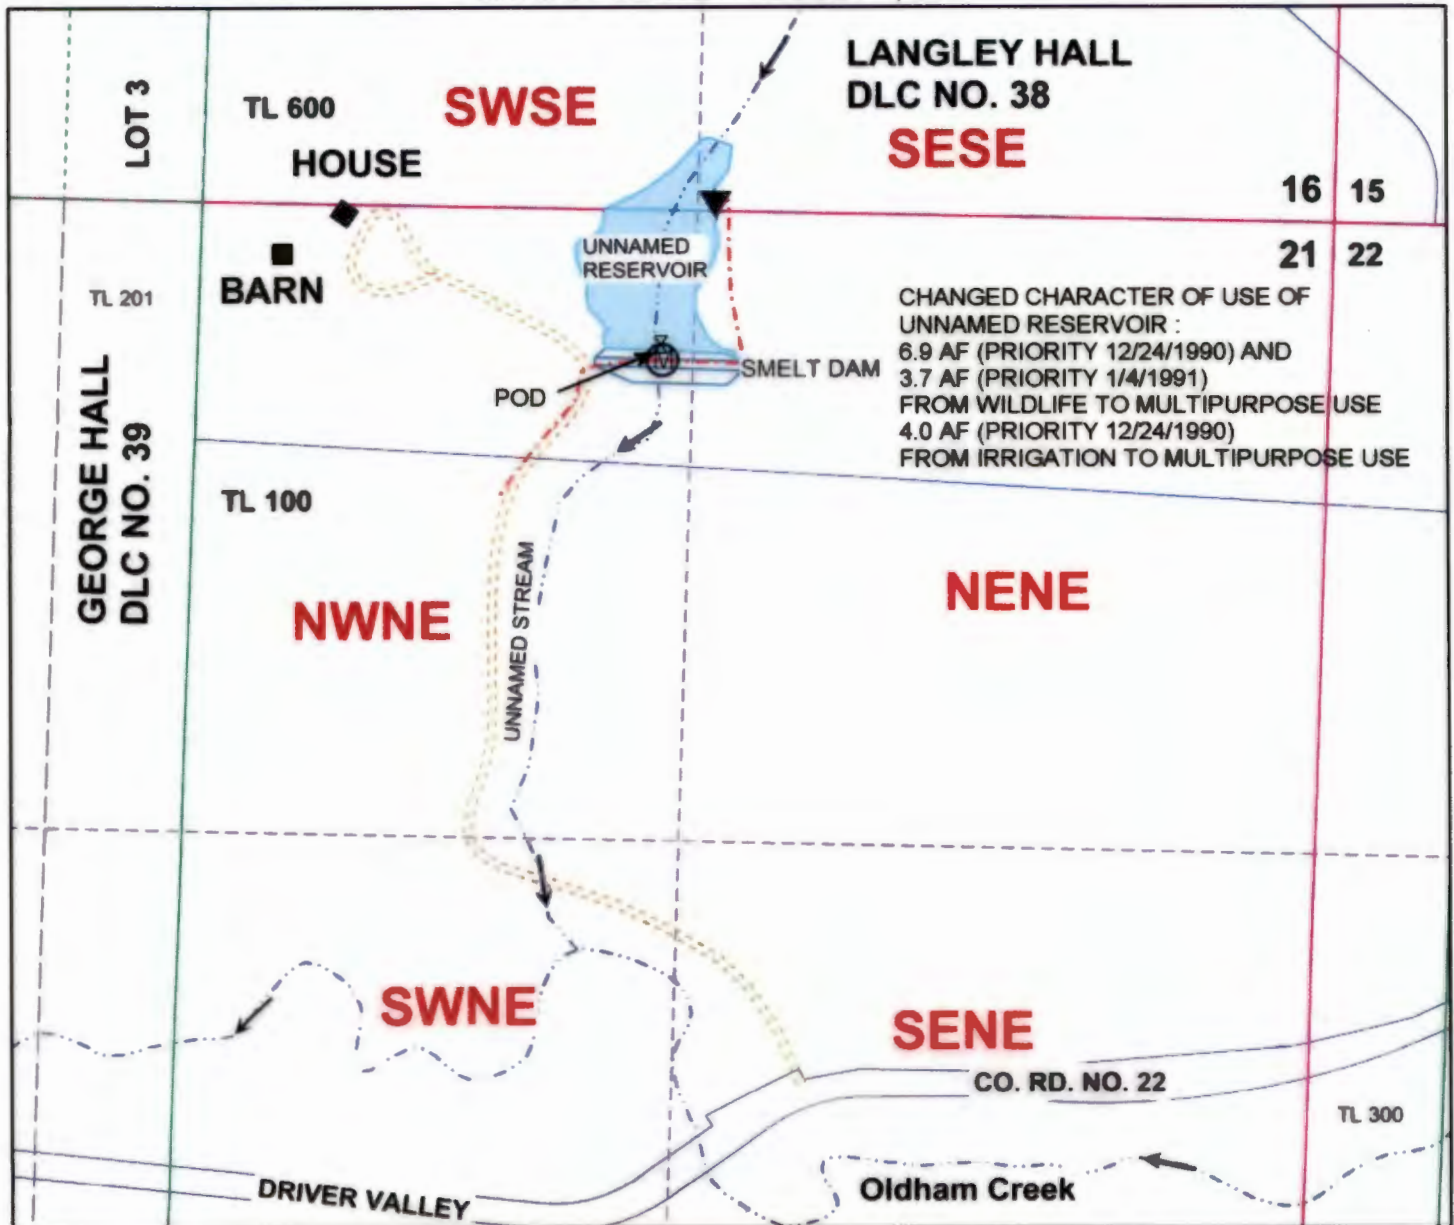

POD IS 250 FEET SOUTH AND 1500 FEET WEST FROM NE CORNER SEC 21

Legend

	Reservoir		Meter		Pipeline		Section
	Stream		PUMP		Driveway		Quarter
	Flow arrow		Structures		Gov Lot		Sixteenth
	POD		DLC		Parcels		

THE PURPOSE OF THIS MAP IS TO IDENTIFY THE LOCATION OF THE WATER RIGHT. IT IS NOT INTENDED TO PROVIDE INFORMATION RELATIVE TO THE LOCATION OF PROPERTY OWNERSHIP BOUNDARY LINES.

MAP PREPARED FOR:
DALE HOLLAND
P.O. BOX 89
7250 DRIVER VALLEY ROAD
OAKLAND, OR 97462

RECEIVED BY OWRD

SEP 13 2017

SALEM, OR

MAP PREPARED BY:
NATHAN R. REED, P.E., CWRE
1113 SE CASS AV
ROSEBURG, OR 97470