



LEGEND


TL 3700
 19 20
 30 29
 SECTION CORNER
 FLOW DIRECTION

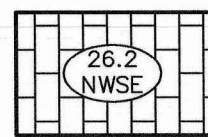


CERTIFICATE 33176
 REMAINING LANDS

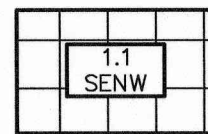


CERTIFICATE 33176
 "FROM" LANDS

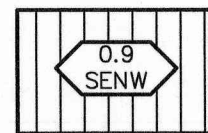

CERTIFICATE 33176
 "TO" LANDS

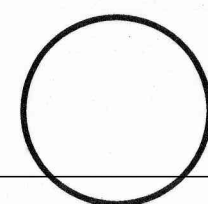

CENTER PIVOT
 CIRCLE

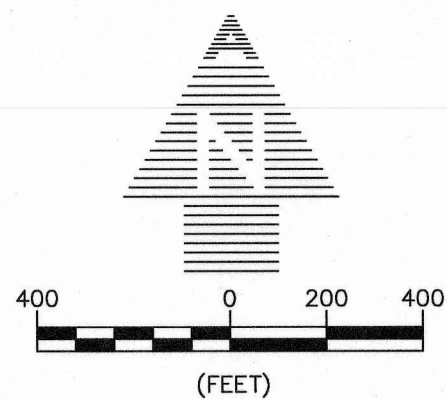



POD LOCATIONS

POD 1: T37S, R10E, W.M., SEC. 19, SW1/4 NE1/4.

POD 2: T37S, R9E, W.M., SEC. 23, NE1/4 SW1/4.

NOTES

1. THE PURPOSE OF THIS MAP IS TO IDENTIFY THE LOCATION OF THE WATER RIGHT ONLY, AND IS NOT INTENDED TO PROVIDE DIMENSIONS OR LOCATION OF PROPERTY LINES.
2. PRIORITY DATE FOR THIS CERTIFICATE IS JUNE 12, 1952.
3. REFERENCE THE MAP FOR CERTIFICATE 83328.

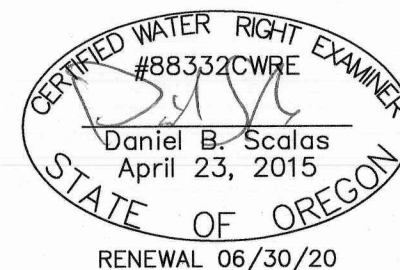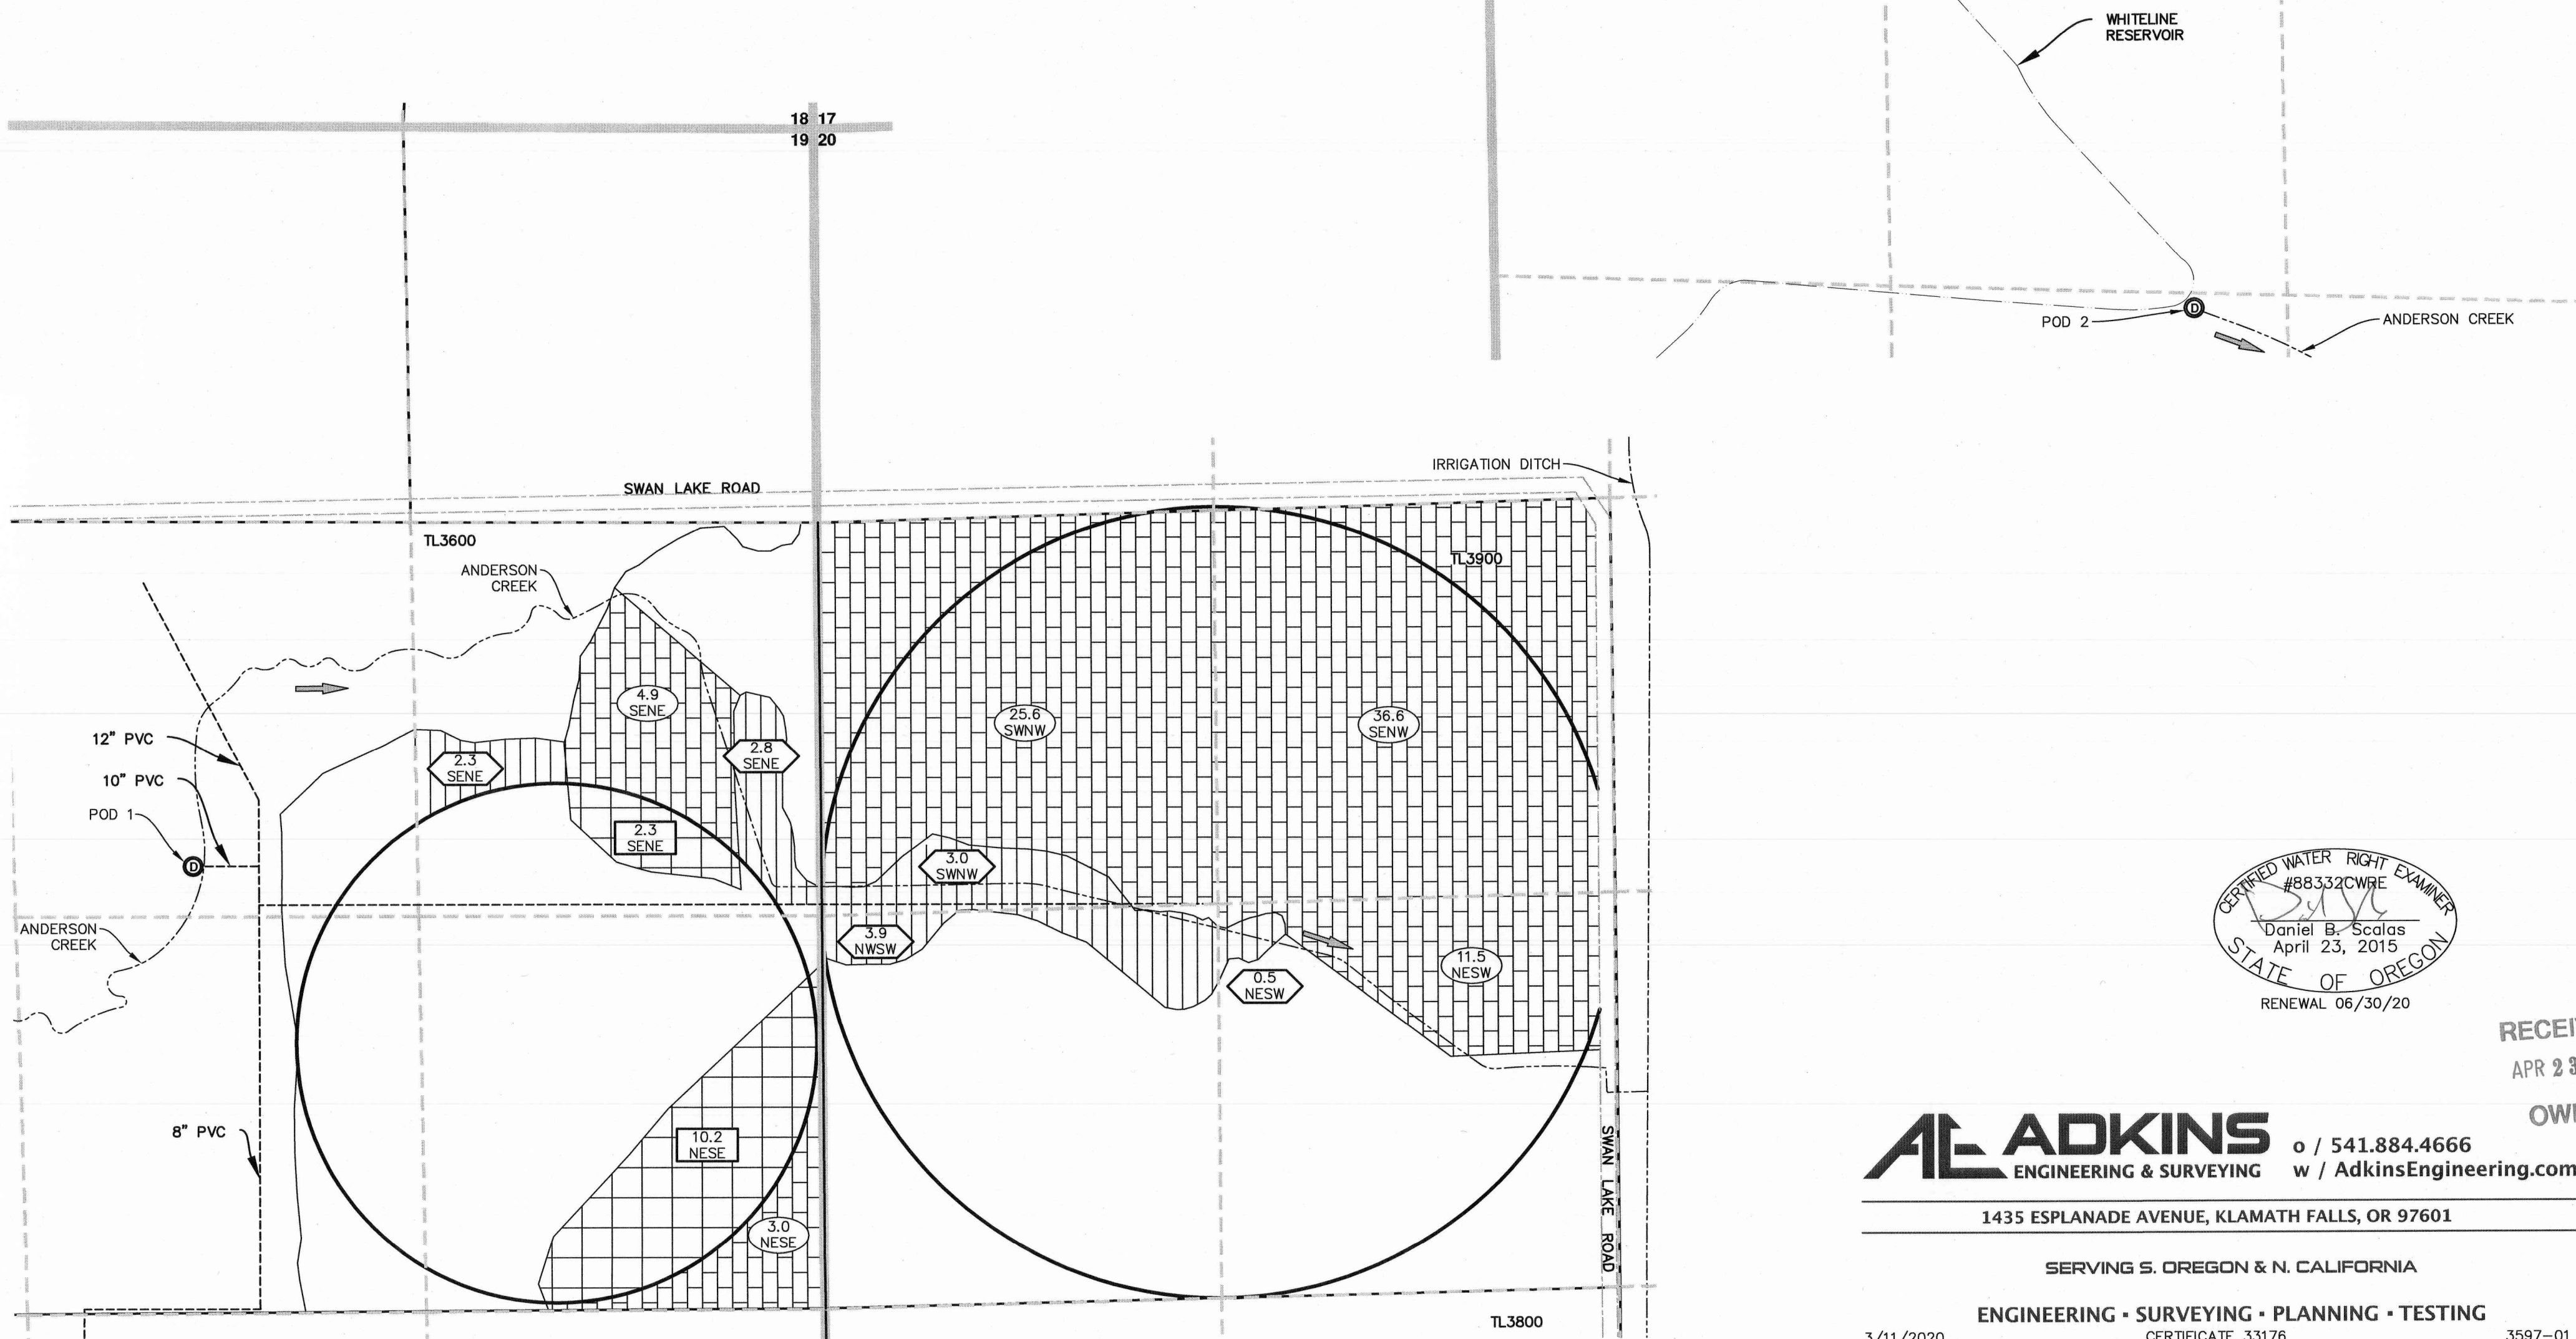

RECEIVED
 APR 23 2020
 OWRD

AL ADKINS o / 541.884.4666
 ENGINEERING & SURVEYING w / AdkinsEngineering.com

1435 ESPLANADE AVENUE, KLAMATH FALLS, OR 97601

SERVING S. OREGON & N. CALIFORNIA


ENGINEERING • SURVEYING • PLANNING • TESTING

3/11/2020


CERTIFICATE 33176

3597-01

T.37S.R.9E.W.M.

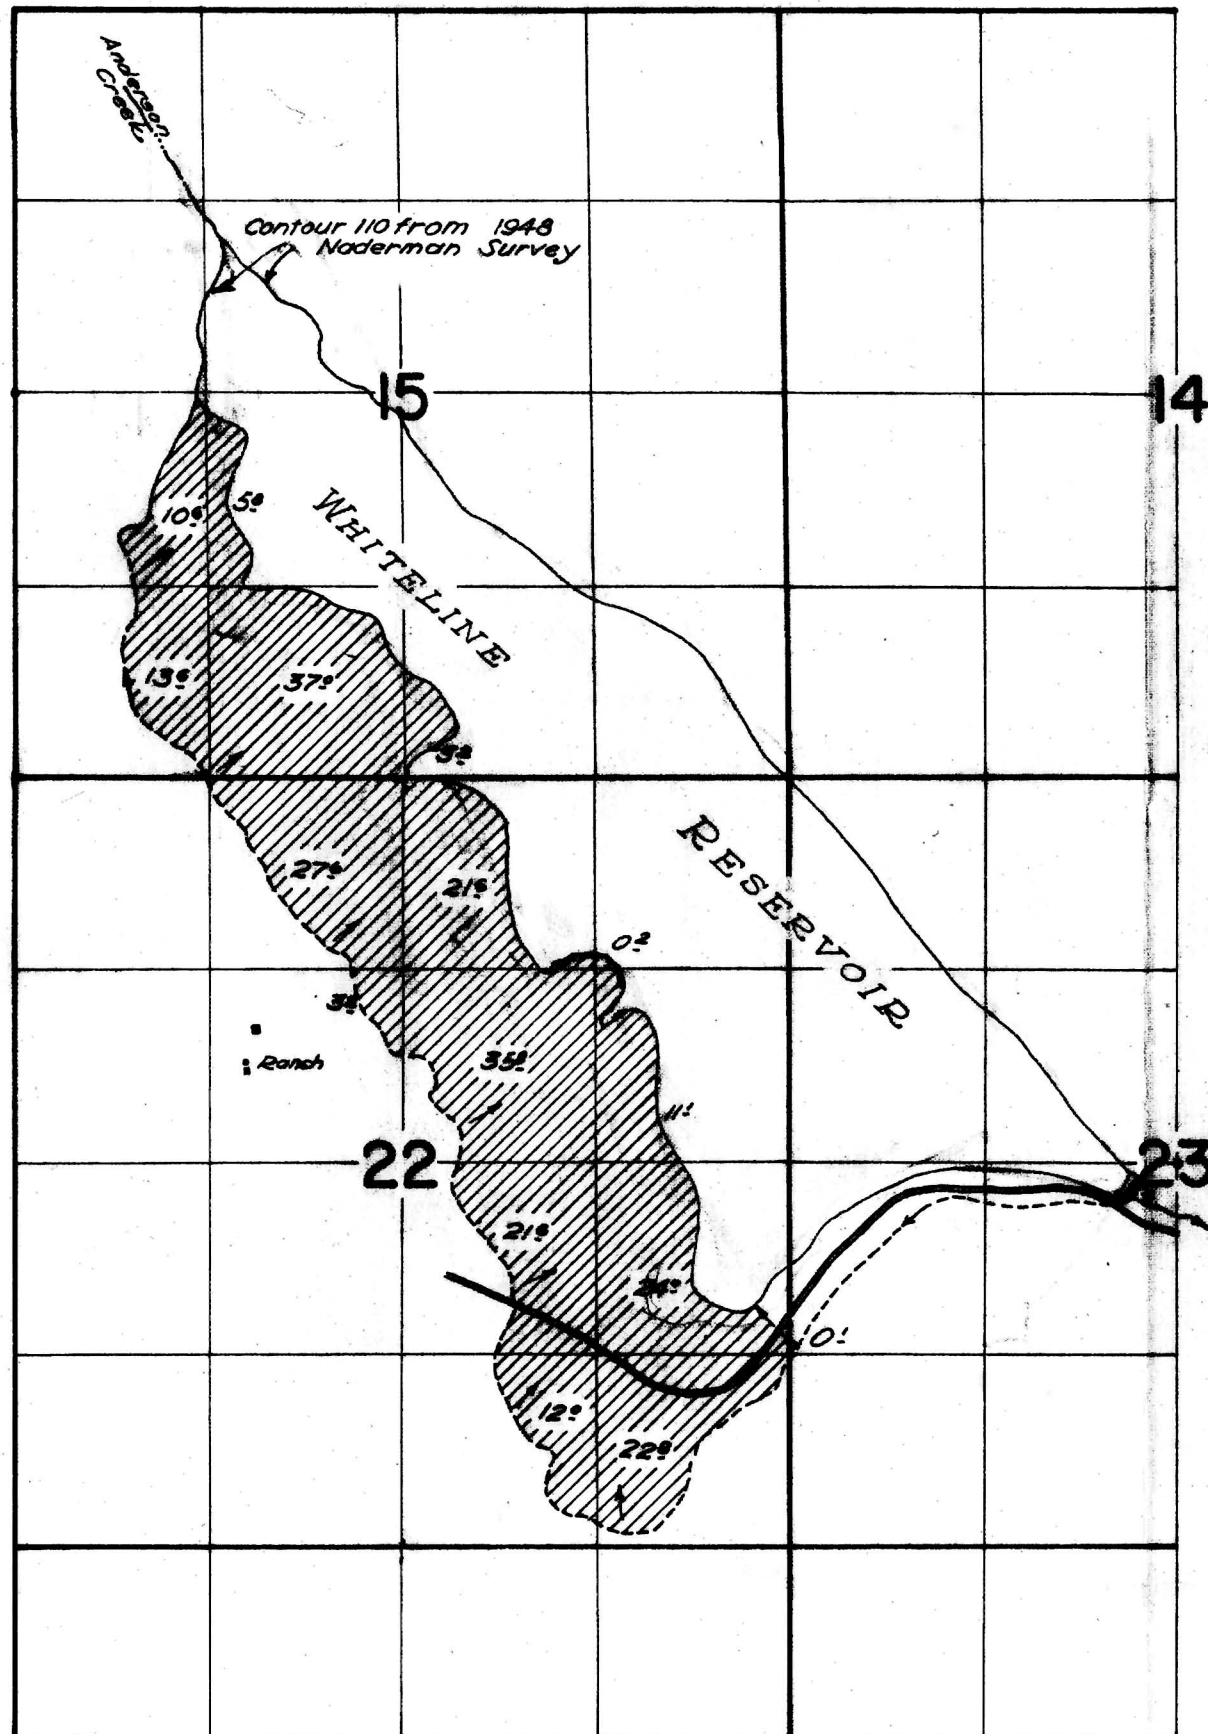

T.37S.R.10E.W.M.

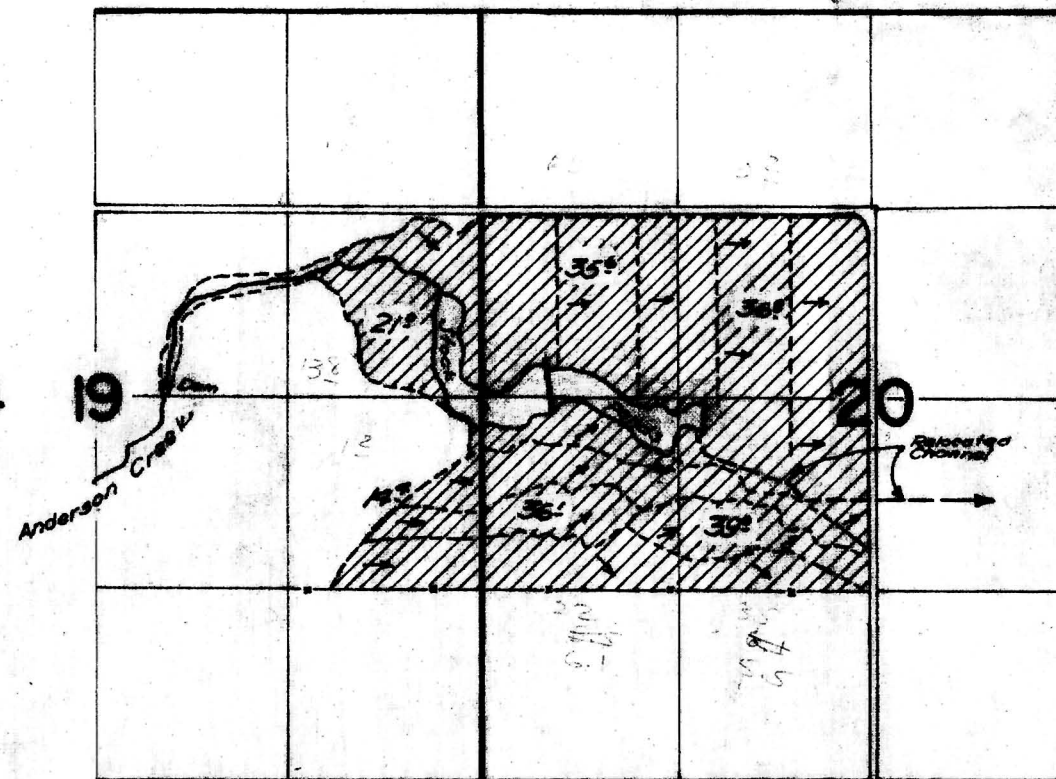

FINAL PROOF SURVEY UNDER

Application No. 19705	Permit No. 15316
R-20521	R-801
20522	16023
24201	19083
27322	21482

IN NAME OF

H. Douglas Whiteline

Surveyed June 15 1961 by

[Signature]