
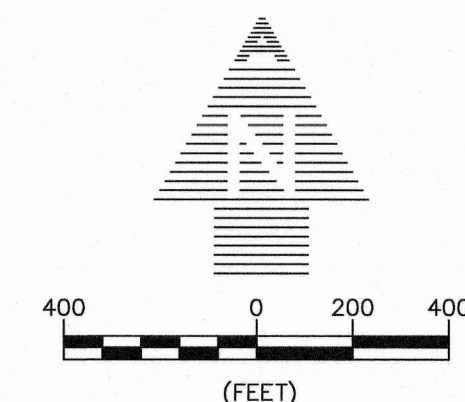
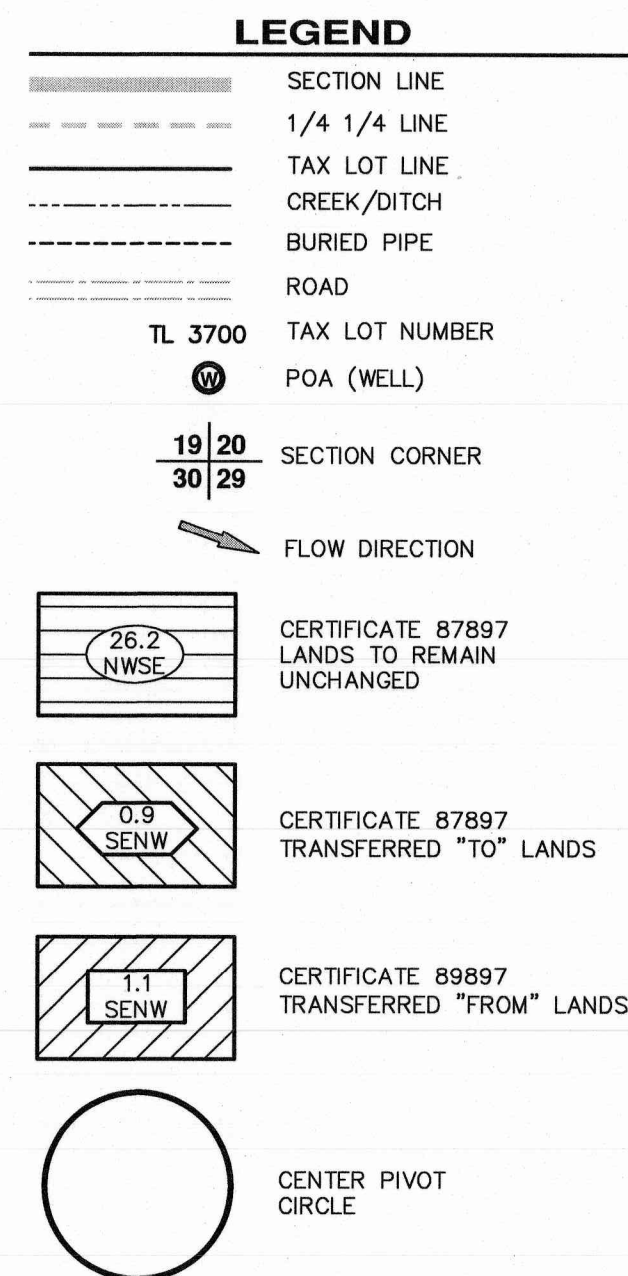


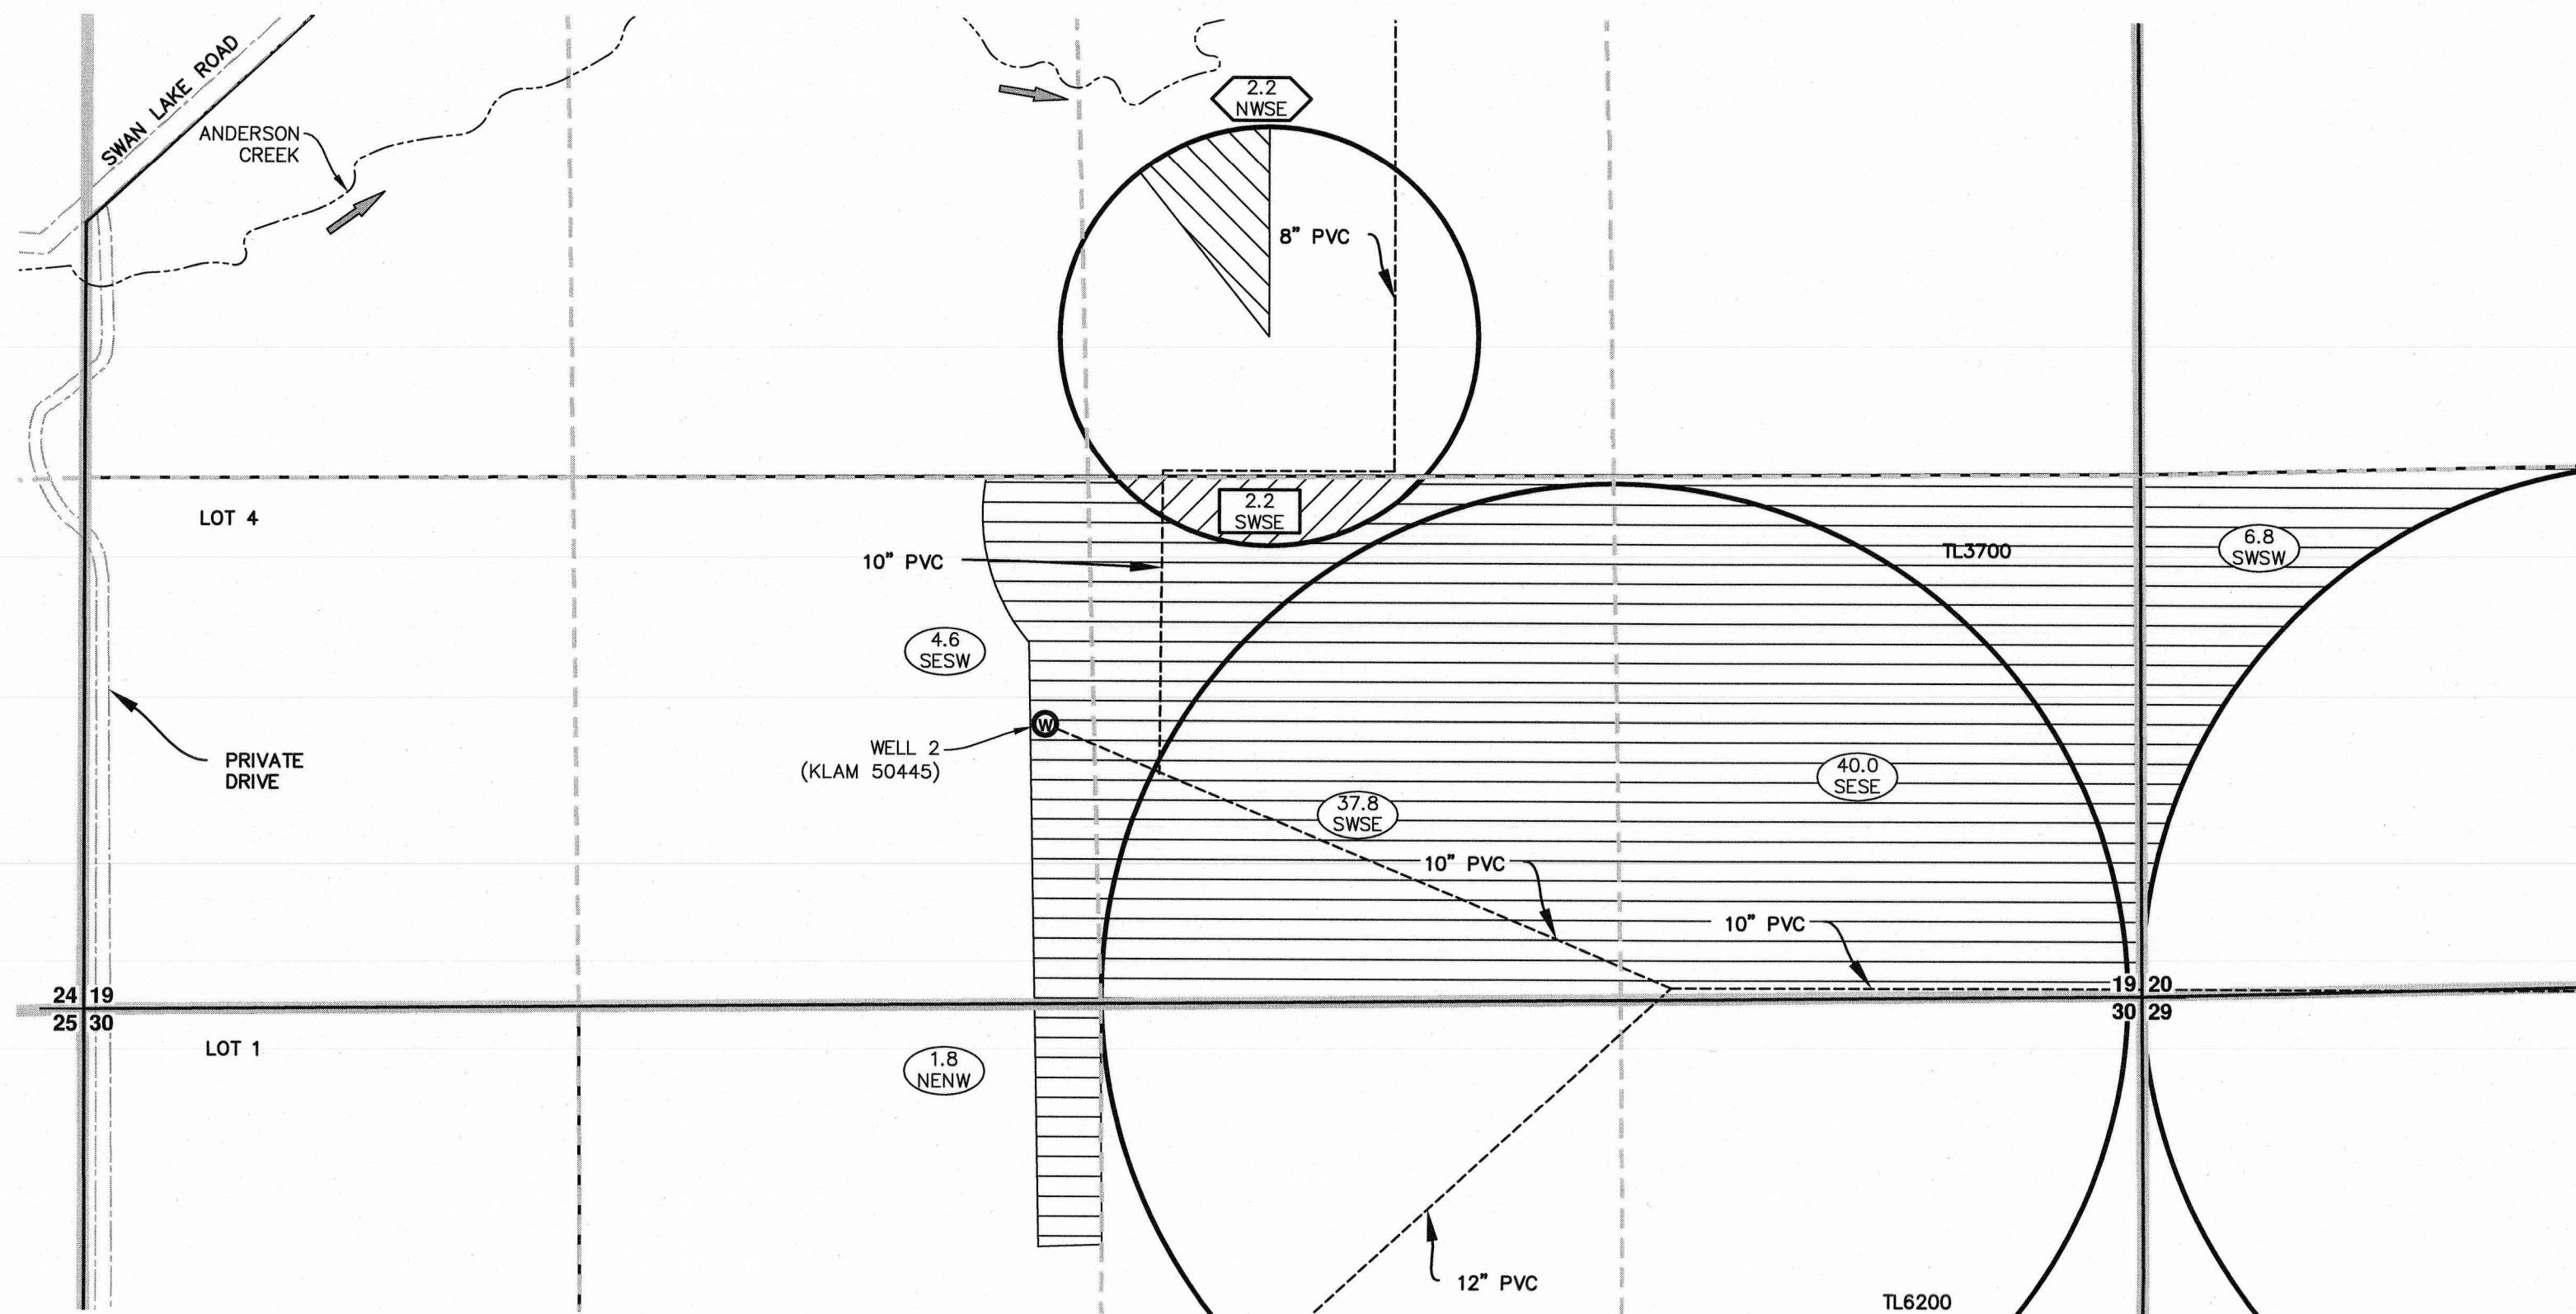


WELL LOCATIONS

WELL 2 (KLAM 50445): T37S, R10E, W.M., SEC. 19, SE1/4 SW1/4; 670 FEET NORTH & 2760 FEET WEST FROM SE CORNER, SECTION 19.

NOTES

1. THE PURPOSE OF THIS MAP IS TO IDENTIFY THE LOCATION OF THE WATER RIGHT ONLY, AND IS NOT INTENDED TO PROVIDE DIMENSIONS OR LOCATION OF PROPERTY LINES.
2. PRIORITY DATE FOR THIS CERTIFICATE IS JANUARY 7, 1999.

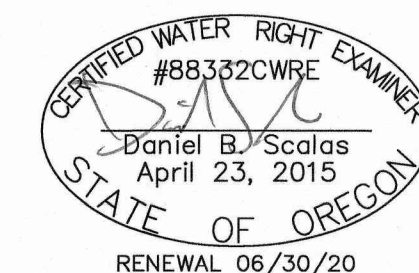

AL ADKINS ENGINEERING & SURVEYING o / 541.884.4666 w / AdkinsEngineering.com

1435 ESPLANADE AVENUE, KLAMATH FALLS, OR 97601

SERVING S. OREGON & N. CALIFORNIA

ENGINEERING • SURVEYING • PLANNING • TESTING

3/11/2020


CERTIFICATE 87897

3597-01

RECEIVED
APR 23 2020
QWRD

FINAL PROOF SURVEY MAP
JELD WEN INC.
Application G-14900 Permit G-13725


T 37 S R 10 E, W.M. Sections 19-20-30

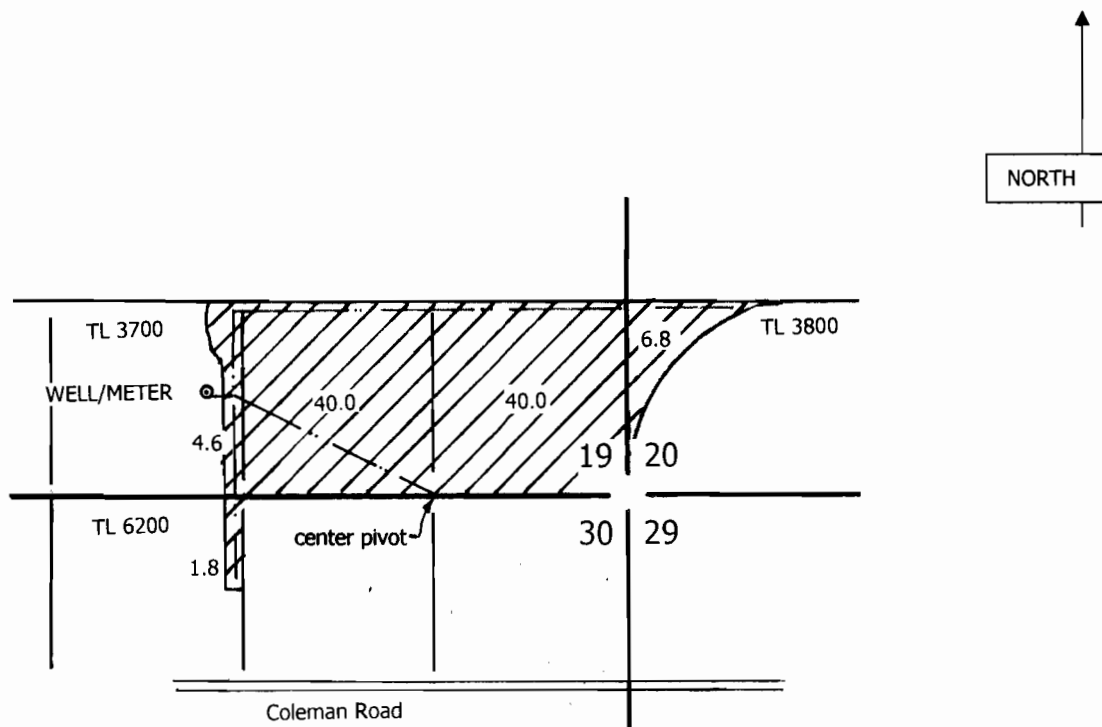

Well/Meter ○
Tax Lot line _____
Section Line _____
1/4 1/4 Line _____
Pipe line _____

Well /Meter: 720' N & 240' W
from the S 1/4 corner Section 19

Scale 4" = 1 mile

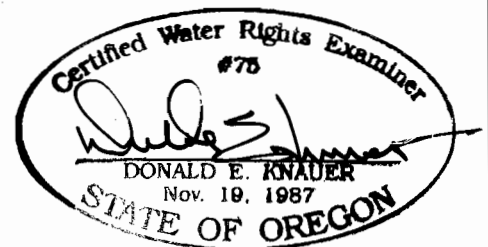

This map is not intended to provide legal dimensions
or locations of property ownership lines.

RENEWAL DATE: 6-30-2011