


CLAIM OF BENEFICIAL USE MAP

T. 13 S R. 1 E WM. SEC. 31

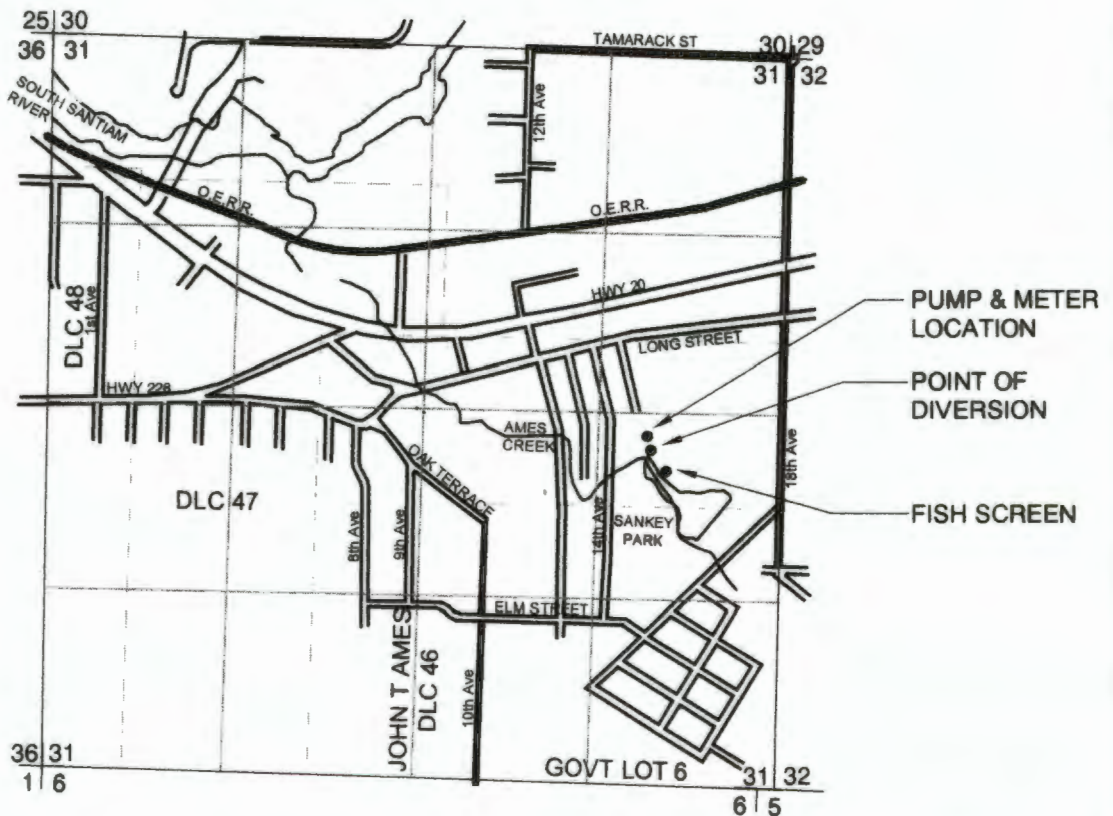

DIV. PT: 360' N AND 310' E OF THE SE COR OF LOT 1, BLOCK 1,
RIDENOUR ADDITION TO THE CITY OF SWEET HOME, OREGON

OWNER: CITY OF SWEET HOME, OREGON
APPLICATION NO: 14057
PERMIT NO: 10140
TRANSFER NO: T8414



0 1320 2640

SCALE: 1" = 1320'

NOTE:

THIS MAP IS FOR THE PURPOSE OF IDENTIFYING THE
LOCATION OF WATER RIGHTS AND HAS NO INTENT
TO DIMENSION OR LOCATE PROPERTY OWNERSHIP LINES

**ERWIN CONSULTING
ENGINEERING**

Date: 8/28/12
Dwn By: MLM
Scale: 1"=1320'

SWEET HOME, OREGON
T.13 S R.1E. W.M. LINN COUNTY