

LEGEND

- SECTION LINE
- 1/4 1/4 LINE
- TAX LOT LINE
- IRRIGATION DITCH
- ROAD
- TL0000 TAX LOT NUMBER
- POA (WELL)
- $\frac{17}{18} | \frac{20}{19}$ SECTION CORNER
- SECTION CENTER
- IRRIGATED UNDER TRANSFER T-12277
- IRRIGATED ACRES
- 1/4 1/4 SECTION

NOTES:


1. THE PURPOSE OF THIS MAP IS TO IDENTIFY THE LOCATION OF THE WATER RIGHT ONLY, AND IS NOT INTENDED TO PROVIDE DIMENSIONS OR LOCATION OF PROPERTY LINES.
2. DATE OF PRIORITY FOR THIS WATER RIGHT IS JANUARY 15, 1976.
3. FOR TAX LOT INFORMATION, SEE TAX LOT MAP 41-14.

WELL TIES:

POA-1 (KILGORE WELL #3) IS LOCATED 1025' NORTH AND 690' EAST FROM THE SOUTHWEST CORNER OF SECTION 8.
 POA-2 (WELL 2) IS LOCATED 240' SOUTH AND 285' EAST FROM THE CENTER OF SECTION 8.

Dennis C. Hitt
 APPLICANT

Janis Hitt
 APPLICANT

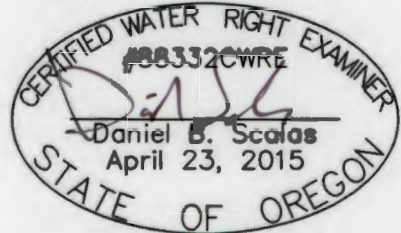

RENEWAL 06/30/20

ALADKINS ENGINEERING & SURVEYING o / 541.884.4666 w / AdkinsEngineering.com
 1435 ESPLANADE AVENUE, KLAMATH FALLS, OR 97601
 SERVING S. OREGON & N. CALIFORNIA

CLAIM OF BENEFICIAL USE AND FINAL PROOF MAP
 FOR
 DENNIS AND JANIS HITT
 T41S, R14E, SEC. 8, WM
 KLAMATH COUNTY, OREGON
 TRANSFER T-12277