


RECEIVED

SEP 13 2018

OWRD

T. 16 S., R. 19 E., W.M.

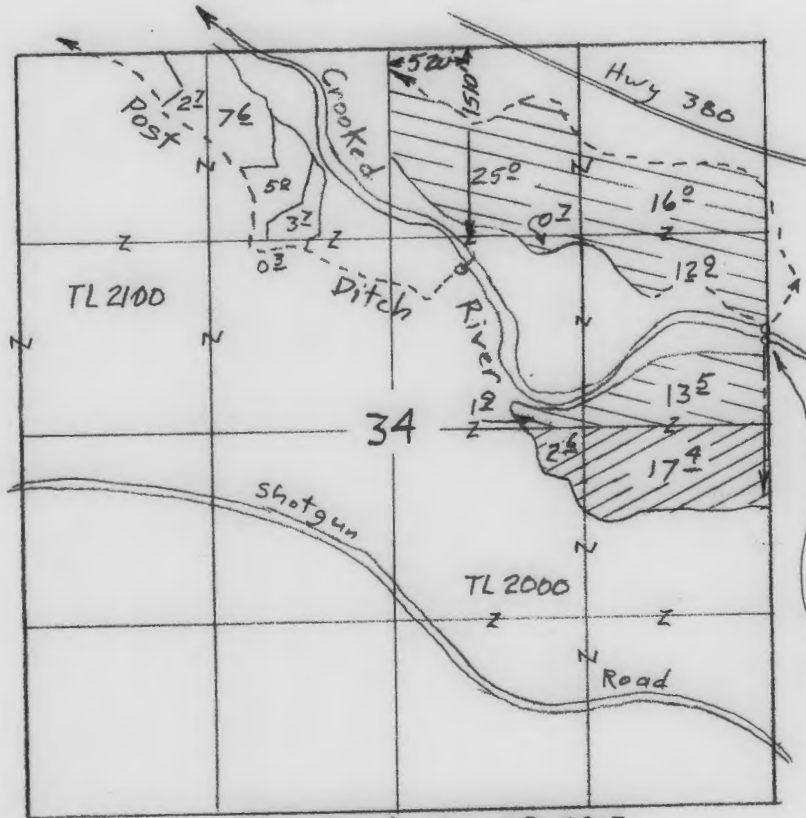

Scale 1" = 1320'
(4" = 1 mile)

PDD's (Joe Post N&S)
2100's ± 10' W from
NE Corner Sec 34
2200's ± 10' W from
NE corner Sec. 34

Surveyed Nov 30, 2017

C-63825 (1916)

- ⊗ To: 20[±] acres
- ⊗ C-92039 70[±] acres
(1916 remaining right)

T-12165

Claim of Beneficial Use Map for Aspen Valley Ranch



Renewal Dec 31, 2019

Sheet 1 of 2

This map is for the purpose of locating a water right only and has no intent to provide legal dimensions or the location of property lines.

ESTES SURVEYS, LLC

PO Box 47519 60382 Arnold Rd
 Salem, OR 97305-7519 Bend, OR 97702
 (503) 565-7593 (541) 382-7391