


RECEIVED

SEP 13 2018


OWRD

T. 16S, R. 19E, W.M.

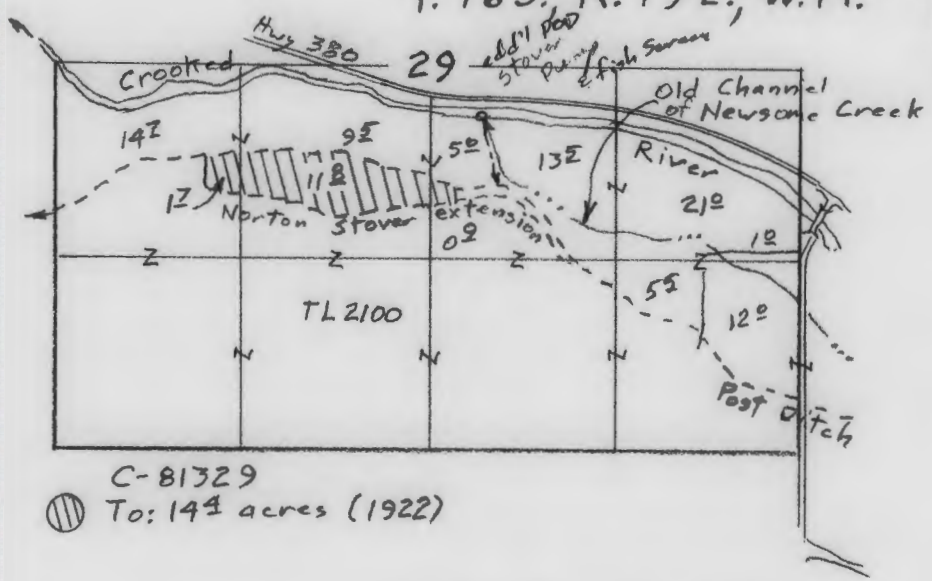

C-81329
 To: 144 acres (1922)

T. 16S, R. 19E, W.M.

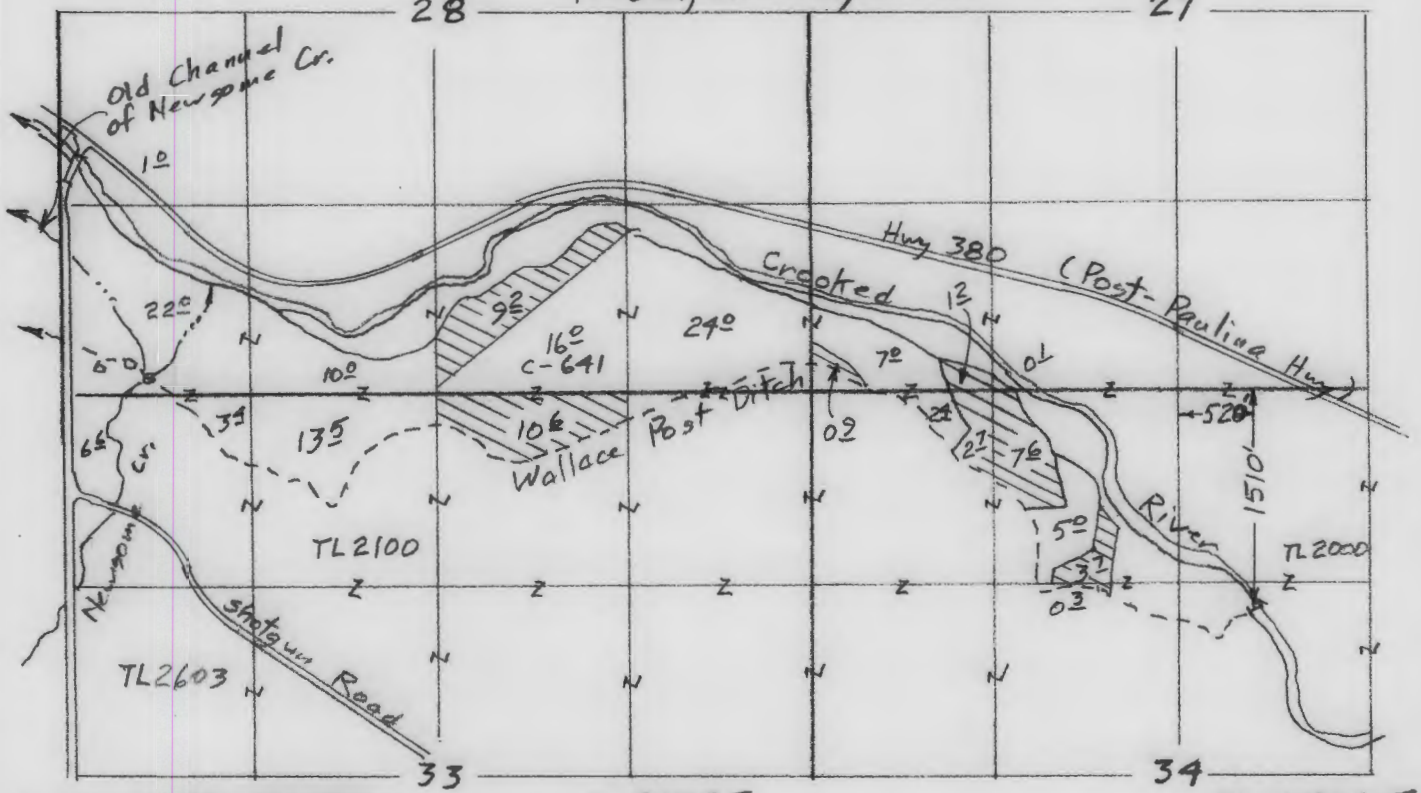

Surveyed Nov 30, 2017

C-81325
 To: 362 acres (1910)

T-12165

Claim of Beneficial Use Map for Aspen Valley Ranch



Renewal Dec 31, 2019

Sheet 2 of 2

This map is for the purpose of
 locating a water right only
 and has no intent to provide
 legal dimensions or the location
 of property lines.

ESTES SURVEYS, LLC

PO Box 17518
 Salem, OR 97305-7519
 (503) 585-7383

60382 Arnold Rd
 Bend, OR 97702
 (541) 382-7391