


T26S R18E, WM
LAKE COUNTY, OREGON



0 1,320
Feet
1" = 1,320'

- Well & Meter
-  POU IR
-  Section
- Quarter Quarter
-  Tax Lot

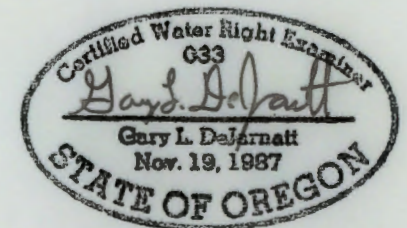


RENEWAL DATE 12/31/2019

RECEIVED

DEC 10 2018

OWRD

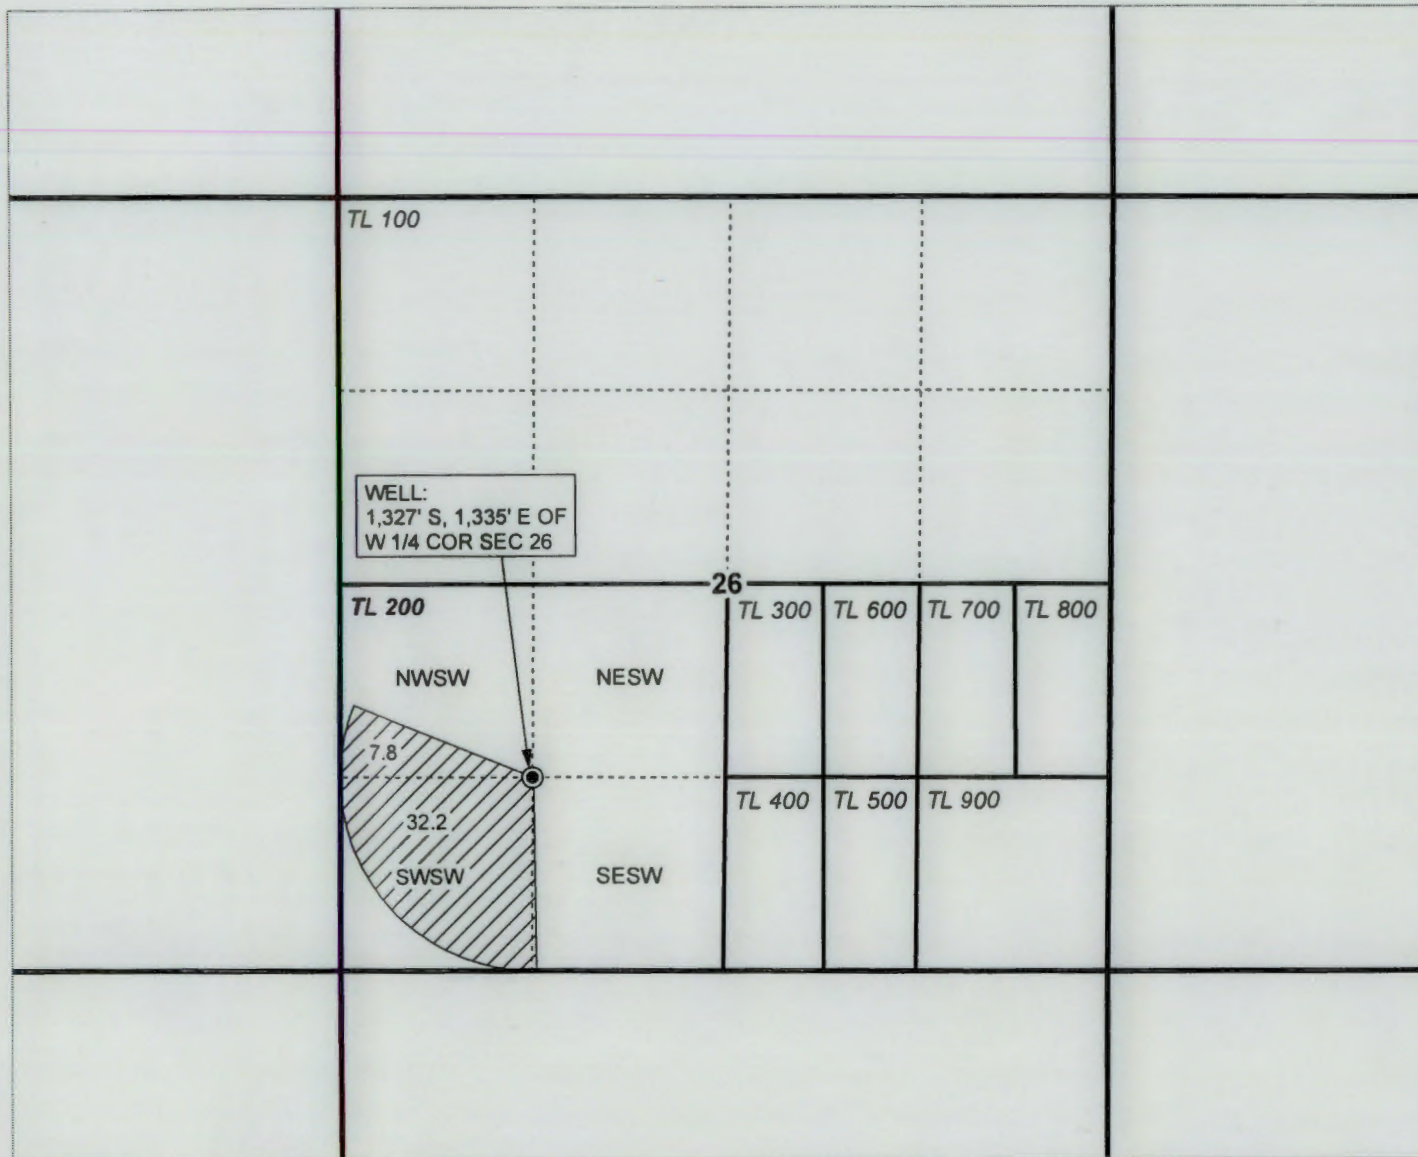

CLAIM OF BENEFICIAL USE MAP
Flowerree Hay & Grain, LLC

T-12186

NOTE: THIS MAP IS NOT INTENDED TO
PROVIDE LEGAL DIMENSIONS OR LOCATIONS
OF PROPERTY OWNERSHIP LINES.

PROJECT #18045

Date: 10/29/2018

WATER RIGHT SERVICES, LLC
PO BOX 1830, BEND, OR 97709
CCB# 197121 www.oregonwater.us
541-389-2837 JOHNSHORT@USA.COM