


NE $\frac{1}{4}$ OF S20, T9S, R7E, W.M.

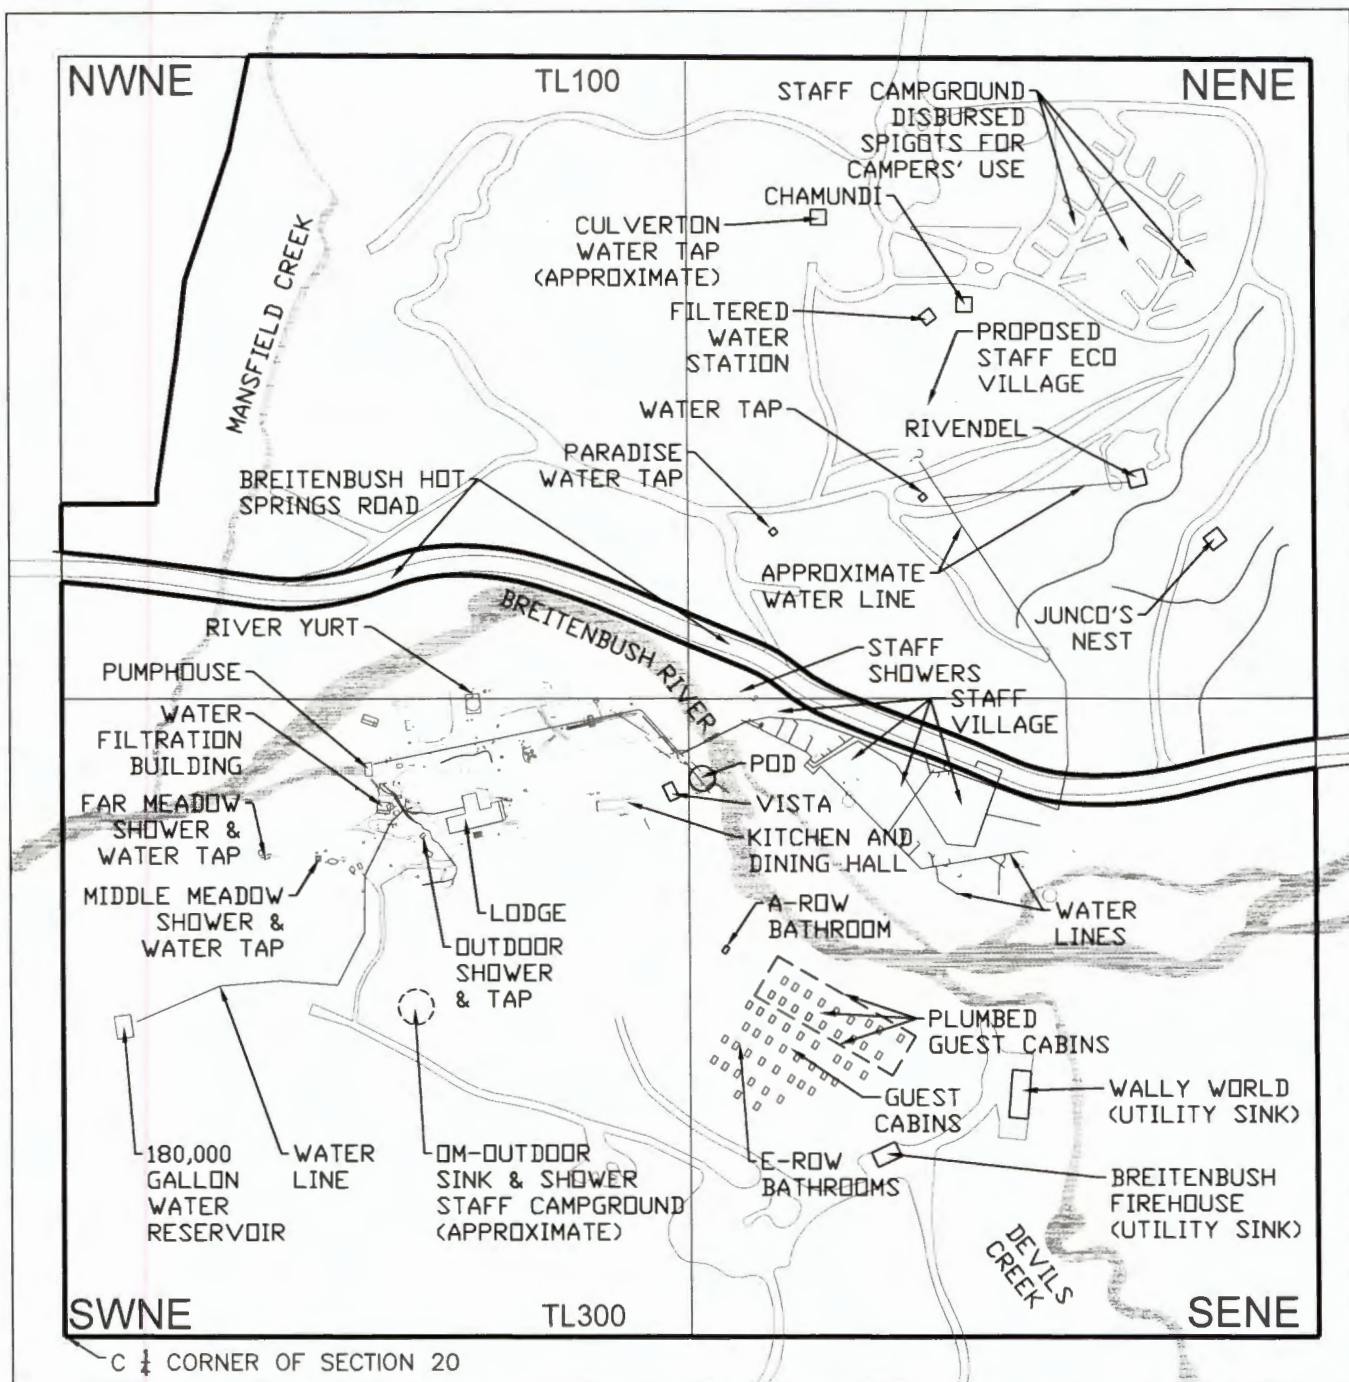

NOTES:

1. AUTHORIZED POD IS NORTH 50°40' EAST 1,780' FROM THE C $\frac{1}{4}$ CORNER OF SECTION 20
2. THE PURPOSE OF THIS MAP IS TO IDENTIFY THE LOCATION OF THE WATER RIGHT. IT IS NOT INTENDED TO PROVIDE INFORMATION RELATIVE TO THE LOCATION OF THE PROPERTY OWNERSHIP BOUNDARY LINES.
3. COBU MAP COMPILED FROM MAPS PROVIDED BY BREITENBUSH HOT SPRINGS, INCLUDING SURVEY DATA FROM HOEKSTRA ENGINEERING JULY 2014, AND WRD'S WATER RIGHT OF RECORD MAP



SCALE IN FEET
1" = 400'



CLAIM OF BENEFICIAL USE MAP
TRANSFER T-12440
BREITENBUSH HOT SPRINGS, DETROIT OREGON

CREATED BY: TAS
DRAWN BY: DJR

DEC 31 2017

OWB

SPRECHER GROUP
2445 NE DIVISION STREET, SUITE 300
BEND, OR 97703
SG PROJECT # 4320
DECEMBER 2018