



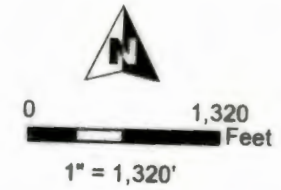

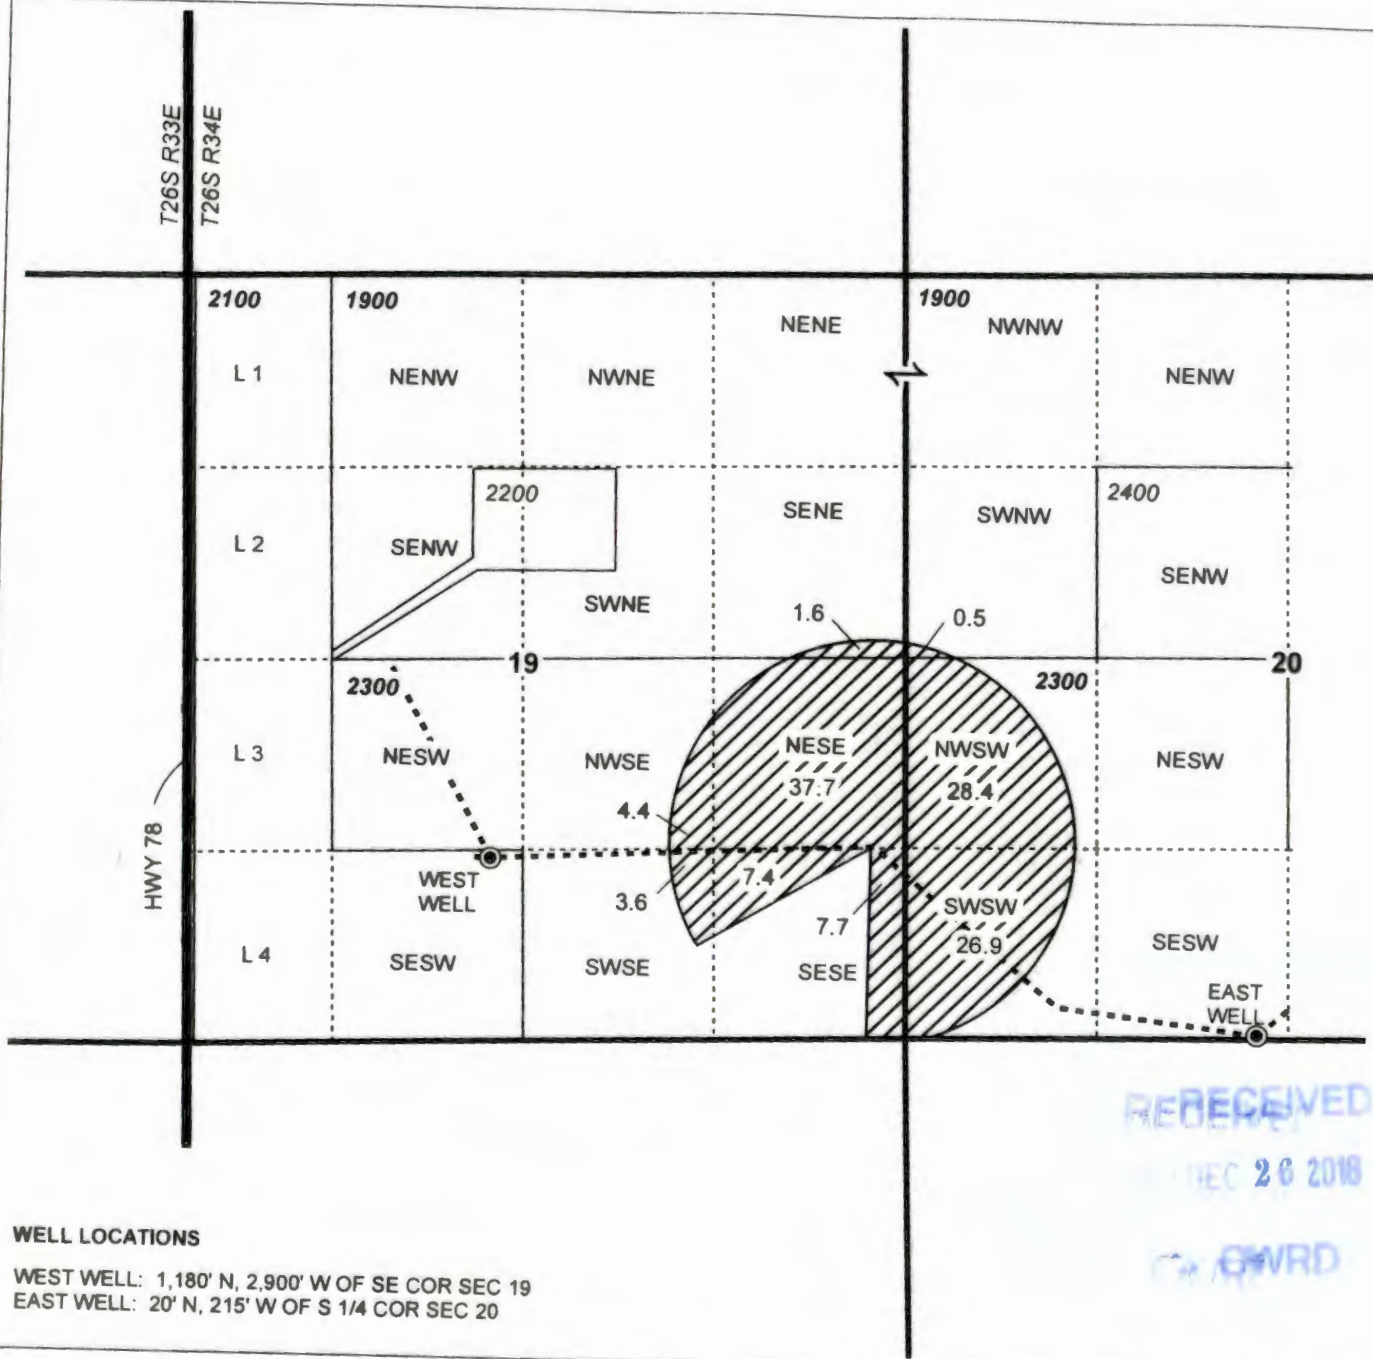


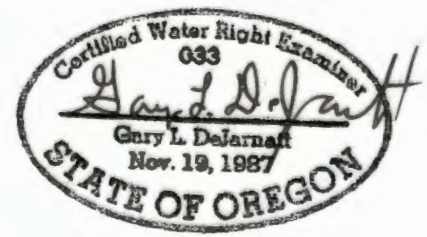


**T26S R34E,
SECTIONS 19 & 20, WM**
HARNEY COUNTY, OREGON



-  POU IR 4/3/1973
-  Township
-  Section
-  Quarter Quarter
-  Tax Lot
-  Well & Meter
-  Pipeline



RENEWAL DATE 12/31/2019



RECEIVED
DEC 26 2018
GWRD

WELL LOCATIONS

WEST WELL: 1,180' N, 2,900' W OF SE COR SEC 19
EAST WELL: 20' N, 215' W OF S 1/4 COR SEC 20

CLAIM OF BENEFICIAL USE MAP
Thompson Ranch
T-12378

NOTE: THIS MAP IS NOT INTENDED TO
PROVIDE LEGAL DIMENSIONS OR LOCATIONS
OF PROPERTY OWNERSHIP LINES.

WATER RIGHT SERVICES, LLC
PO BOX 1830, BEND, OR 97709
CCB# 197121 www.oregonwater.us
541-389-2837 JOHNSHORT@USA.COM