

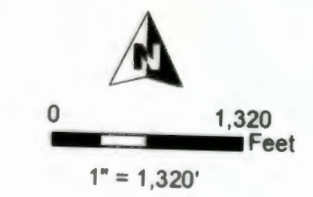


**T26S R34E,
SECTIONS 20 & 29, WM**
HARNEY COUNTY, OREGON

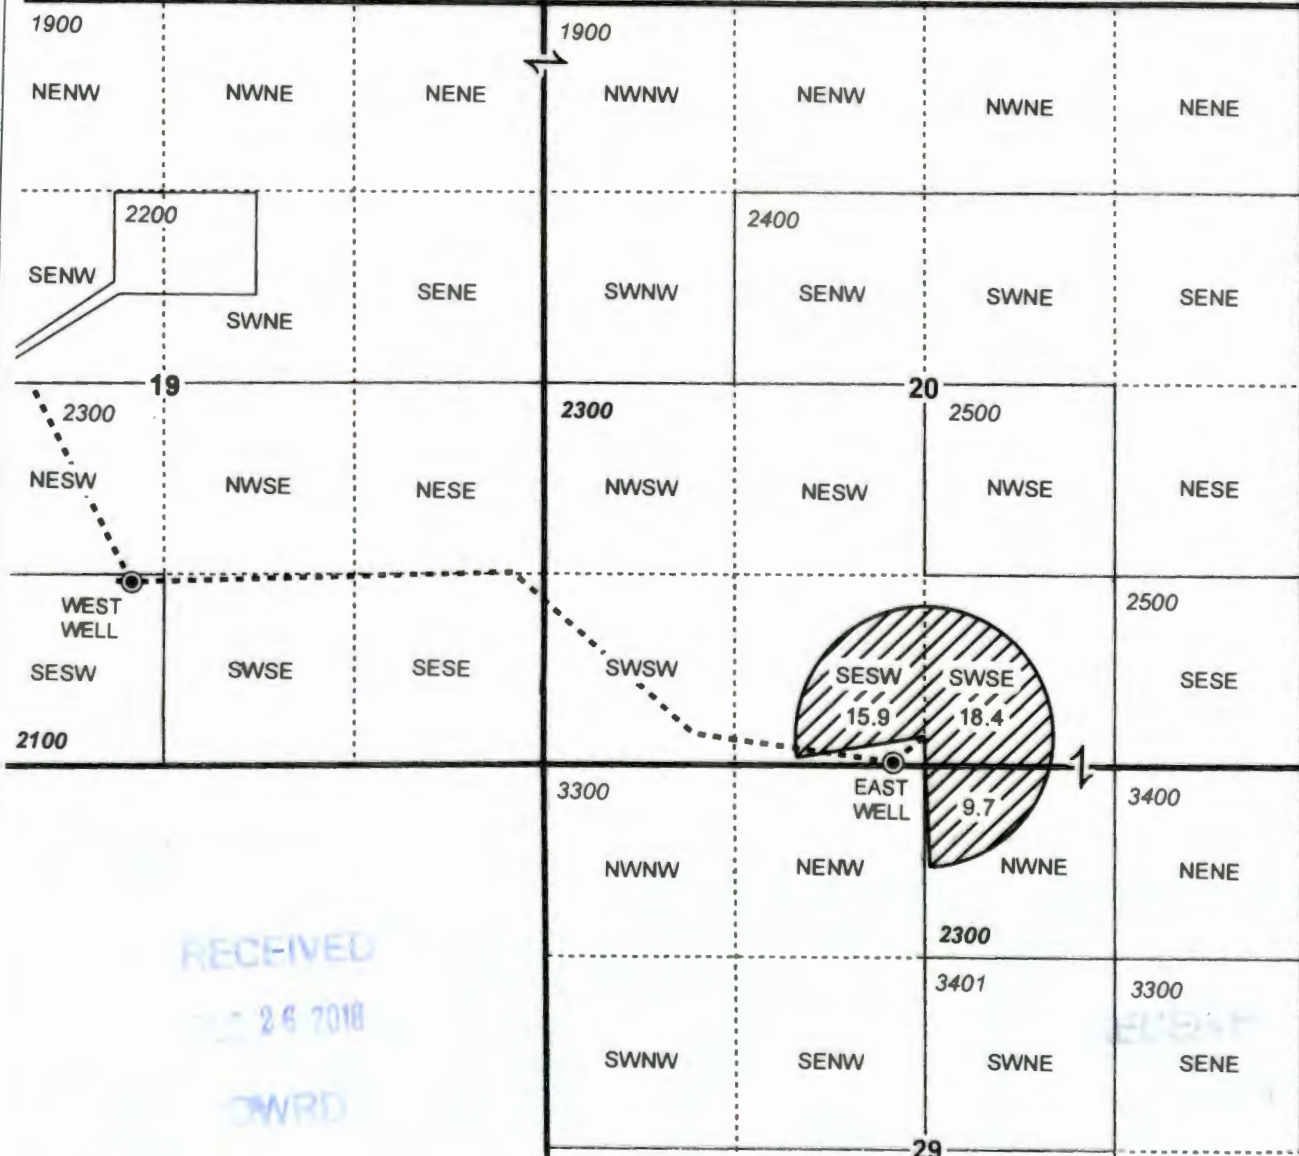

- POU IR 3/10/1992
- Section
- Quarter Quarter
- Tax Lot
- Well & Meter
- Pipeline

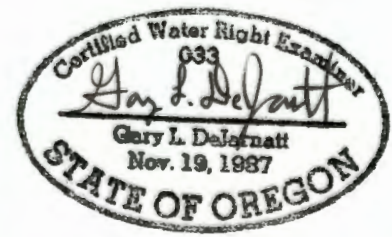

RENEWAL DATE 12/31/2019



RECEIVED
DEC 26 2018
OWRD

WELL LOCATIONS
WEST WELL: 1,180' N, 2,900' W OF SE COR SEC 19
EAST WELL: 20' N, 215' W OF S 1/4 COR SEC 20

CLAIM OF BENEFICIAL USE MAP
Thompson Ranch
T-12378

PG 1 OF 7



NOTE: THIS MAP IS NOT INTENDED TO
PROVIDE LEGAL DIMENSIONS OR LOCATIONS
OF PROPERTY OWNERSHIP LINES.


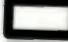





PROJECT #18047


Date: 12/10/2018

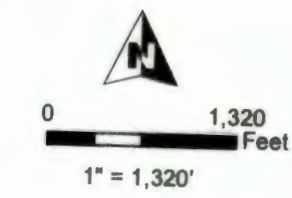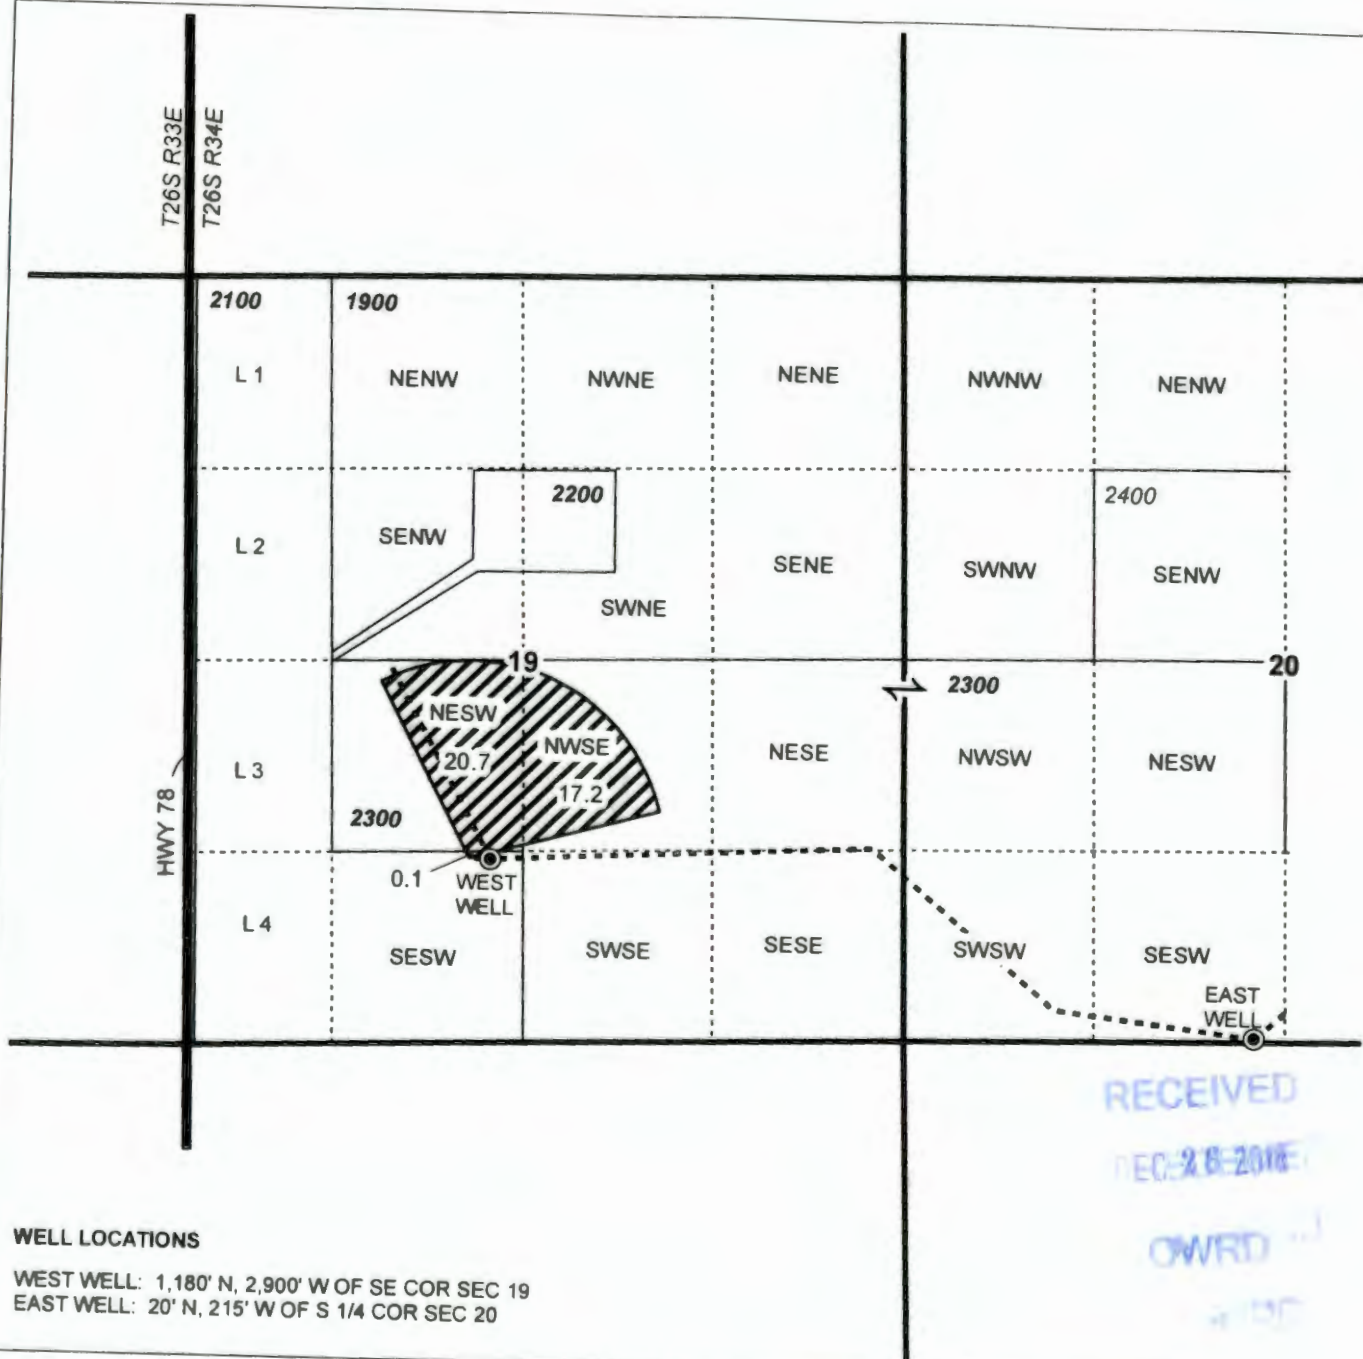WATER RIGHT SERVICES, LLC
PO BOX 1830, BEND, OR 97709
CCB# 197121 www.oregonwater.us
541-389-2837 JOHNSHORT@USA.COM

T26S R34E,
 SECTIONS 19 & 20, WM
 HARNEY COUNTY, OREGON



-  POU IR 3/10/1992
-  Township
-  Section
-  Quarter Quarter
-  Tax Lot
-  Well & Meter
-  Pipeline

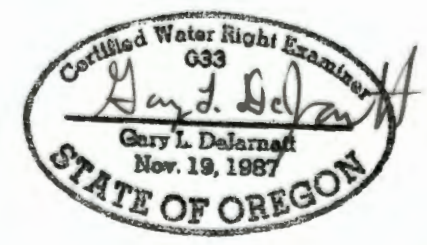

RENEWAL DATE 12/31/2019



WELL LOCATIONS
 WEST WELL: 1,180' N, 2,900' W OF SE COR SEC 19
 EAST WELL: 20' N, 215' W OF S 1/4 COR SEC 20

CLAIM OF BENFICIAL USE MAP
 Thompson Ranch
 T-12378

NOTE: THIS MAP IS NOT INTENDED TO
 PROVIDE LEGAL DIMENSIONS OR LOCATIONS
 OF PROPERTY OWNERSHIP LINES.

WATER RIGHT SERVICES, LLC
 PO BOX 1830, BEND, OR 97709
 CCB# 197121 www.oregonwater.us
 541-389-2837 JOHNSHORT@USA.COM