

STATE HWY 293  
(ANTELOPE HWY)

TL 1000

TL 1000

RECEIVED  
JAN 17 2019

OWRD



0 400 Feet  
1" = 400'

T8S R16E, WM  
WASCO COUNTY, OREGON

SWSE

SESE

SWSW

COUNTY RD 308  
(LOWER TUB SPRINGS RD)

- POU (IS) 1968
- POU (IS) 1971
- POU IR 1968
- Section
- Quarter Quarter
- Tax Lot
- Well
- Meter for Well #1 & #2
- Pipeline

16

15

21

22

TL 1000

NWNE

(4.3)

Antelope Creek

(0.5)

NENE

NWNW

(7.8)

(1.6)

(20.9)


#2

#1

20

WELL LOCATIONS:

#1 / WASC 3899: 670' N, 60' E of SW COR, NW 1/4 NW 1/4, SEC 22  
#2 / L-91161: 490' N, 70' W of SW COR, NW 1/4 NW 1/4, SEC 22

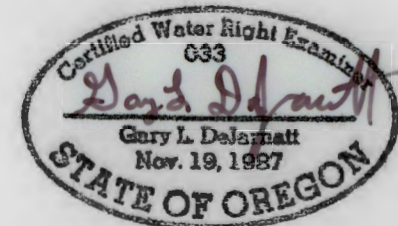

RENEWAL DATE 12/31/2019

**CLAIM OF BENEFICIAL USE MAP**  
Forman Ranch

NOTE: THIS MAP IS NOT INTENDED TO  
PROVIDE LEGAL DIMENSIONS OR LOCATIONS  
OF PROPERTY OWNERSHIP LINES.

**WATER RIGHT SERVICES, LLC**

PO BOX 1830, BEND, OR 97709  
CCB# 197121 www.oregonwater.us  
541-389-2837 JOHNSHORT@USA.COM