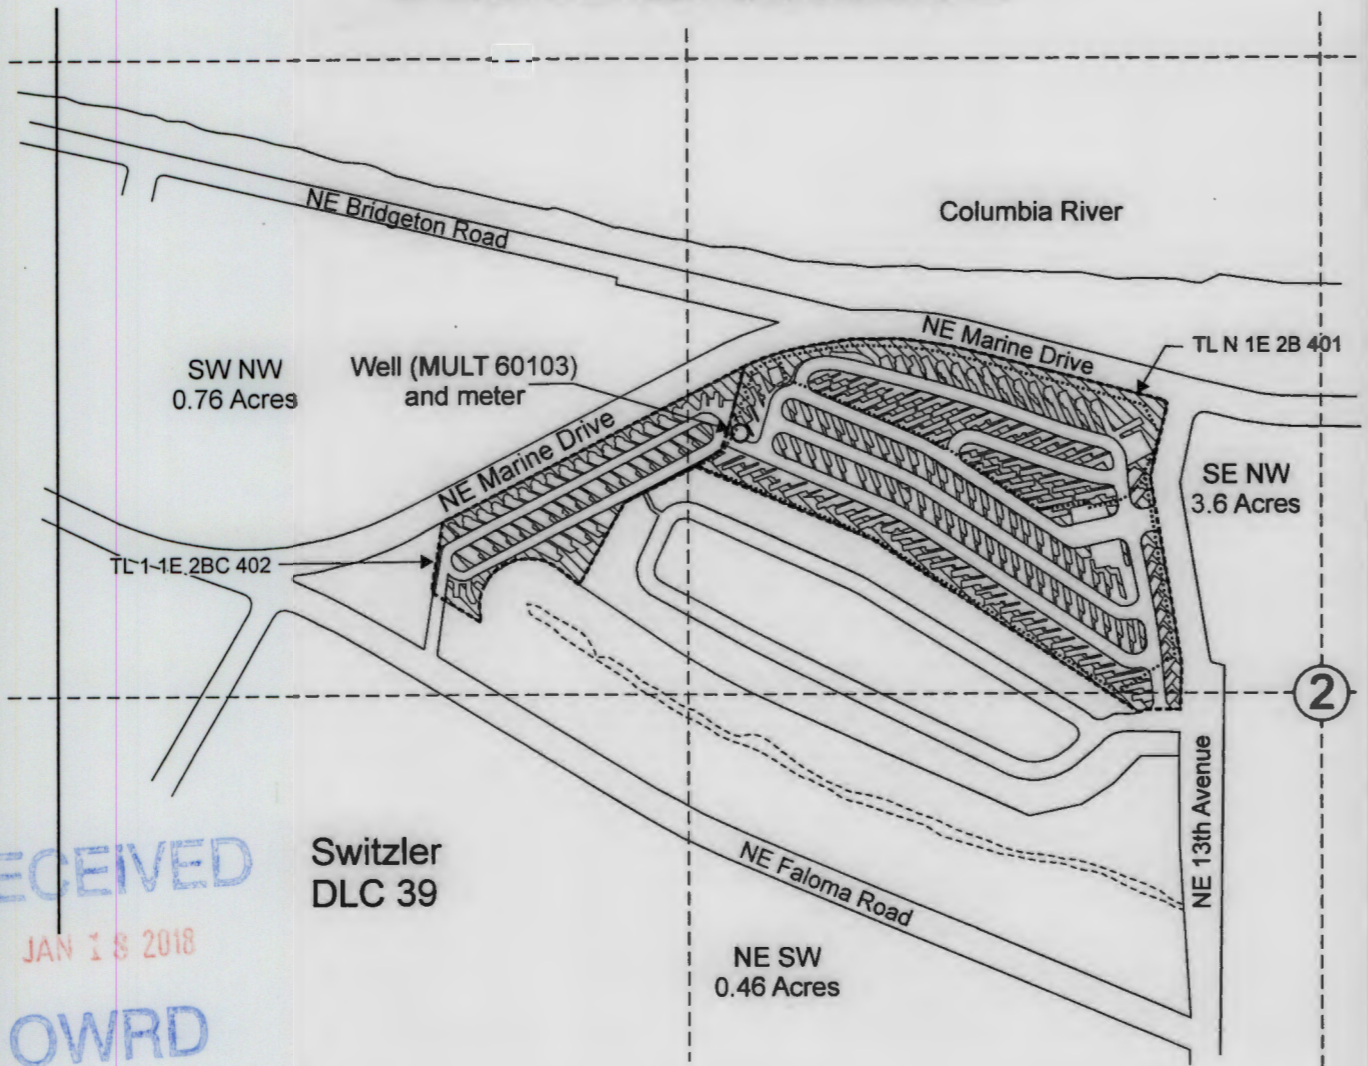


T.1N. R.1E. Section 2



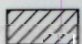
RECEIVED

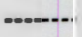
JAN 18 2018

OWRD

Switzler
DLC 39

Well (MULT 60103) is located 540 feet north and 1,210 feet west from the center, Section 2.

 Area (4.82 acres) irrigated under application G-16029, Permit G-15651.

 Tax lot boundary

 Mainline

Scale: 1" = 400'



RENEWED June 30, 2019

This map was prepared for the purpose of identifying the location of a water right only and is not intended to provide legal dimensions or location of property ownership lines.

Claim of Beneficial Use Map
Application G-16029, Permit G-15651

Pacific Hydro-Geology Inc.

Delta Management Company
T.1N. R.1E. Section 2, W.M.

01/2018