
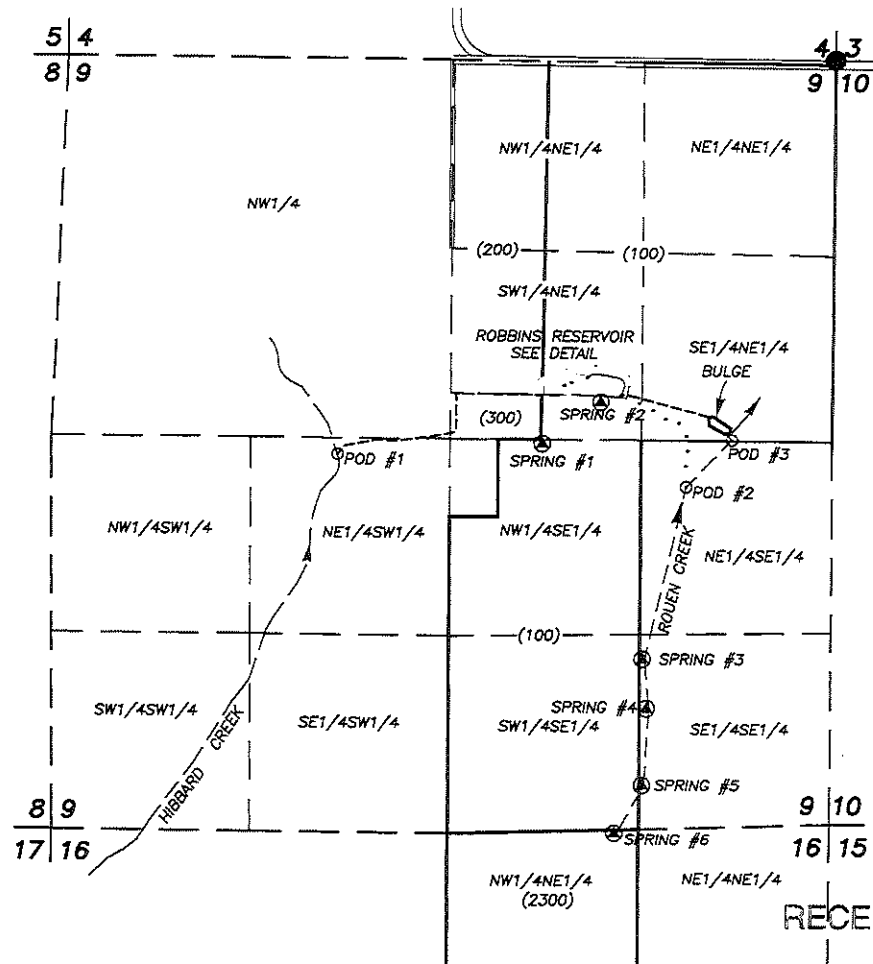


SECTION 9, T.9S., R.39E., W.M.


1096

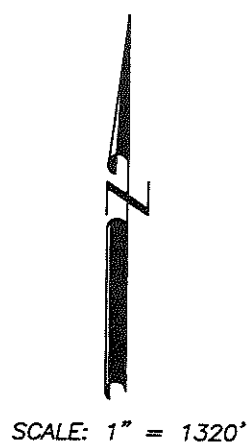

RECEIVED BY OWRD

SEP 20 2017

SALEM, OR

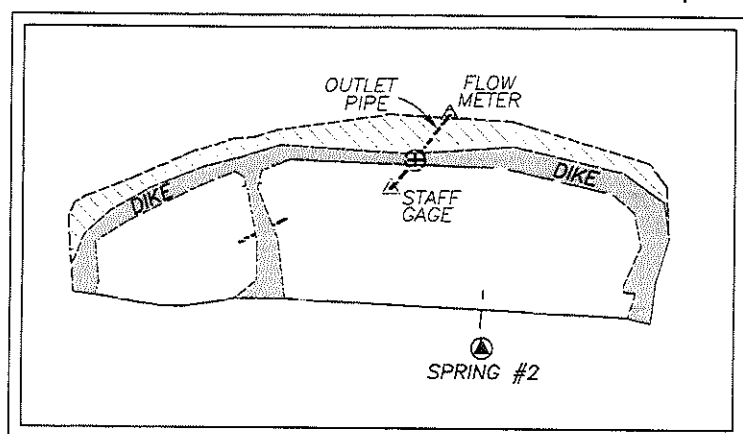

ROBBINS RESERVOIR

DETAIL

SCALE: 1"=200'

ROBBINS RESERVOIR

1096

POD'S & SPRINGS:

NOTE: POD & Spring Coordinates are from the NE Corner Section 9

FINAL PROOF SURVEY

Under

PERMIT R-13114
APPLICATION R-84681


In Name Of

DENZIL ROBBINS

Storage Facility: Robbings Reservoir

Prepared by: Robert D. Baggett, PLS, CWRE
217 N. Canyon Blvd.
John Day, Oregon 97845
(541) 575-1251

Date Surveyed: August 17, 2017

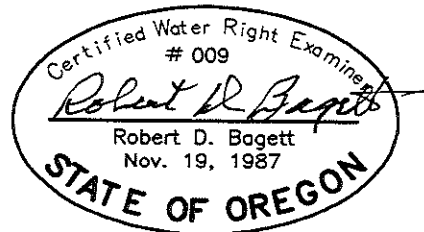

RENEWS: 12/31/2017

- POD #1: 2710' South & 3390' West
- POD #2: 2920' South & 1000' West
- POD #3: 2600' South & 690' West
- ⊙ Spring #1: 2630' South & 3390' West - Spillman Spring
- ⊙ Spring #2: 2360' South & 1560' West- Unnamed
- ⊙ Spring #3: 4110' South & 1290' West- Unnamed
- ⊙ Spring #4: 4450' South & 1260' West- Unnamed
- ⊙ Spring #5: 4980' South & 1290' West- Unnamed
- ⊙ Spring #6: 5310' South & 1470' West- Unnamed

- ⊕ MIDDLE CENTERLINE OF DAM AT OUTLET PIPE IS 2140 FT. SOUTH & 1660 WEST FROM THE NE CORNER SEC. 9

MEASURING DEVICE: STAFF GAGE IN RESERVOIR BEARS S40°15'W, 38.7 FT. FROM MIDDLE CENTERLINE OF DAM

FLOW METER BEARS N40°15'E, 59.0 FT. FROM MIDDLE CENTERLINE OF DAM

- PIPELINE
- DITCH
- TAX LOT LINE
- () TAX LOT

- FD. REFERENCE POINT: 5/8" REBAR 30' NORTH OF NE COR. SEC. 9

THIS MAP IS NOT INTENDED TO PROVIDE LEGAL DIMENSIONS OR LOCATIONS OF PROPERTY OWNERSHIP LINES