


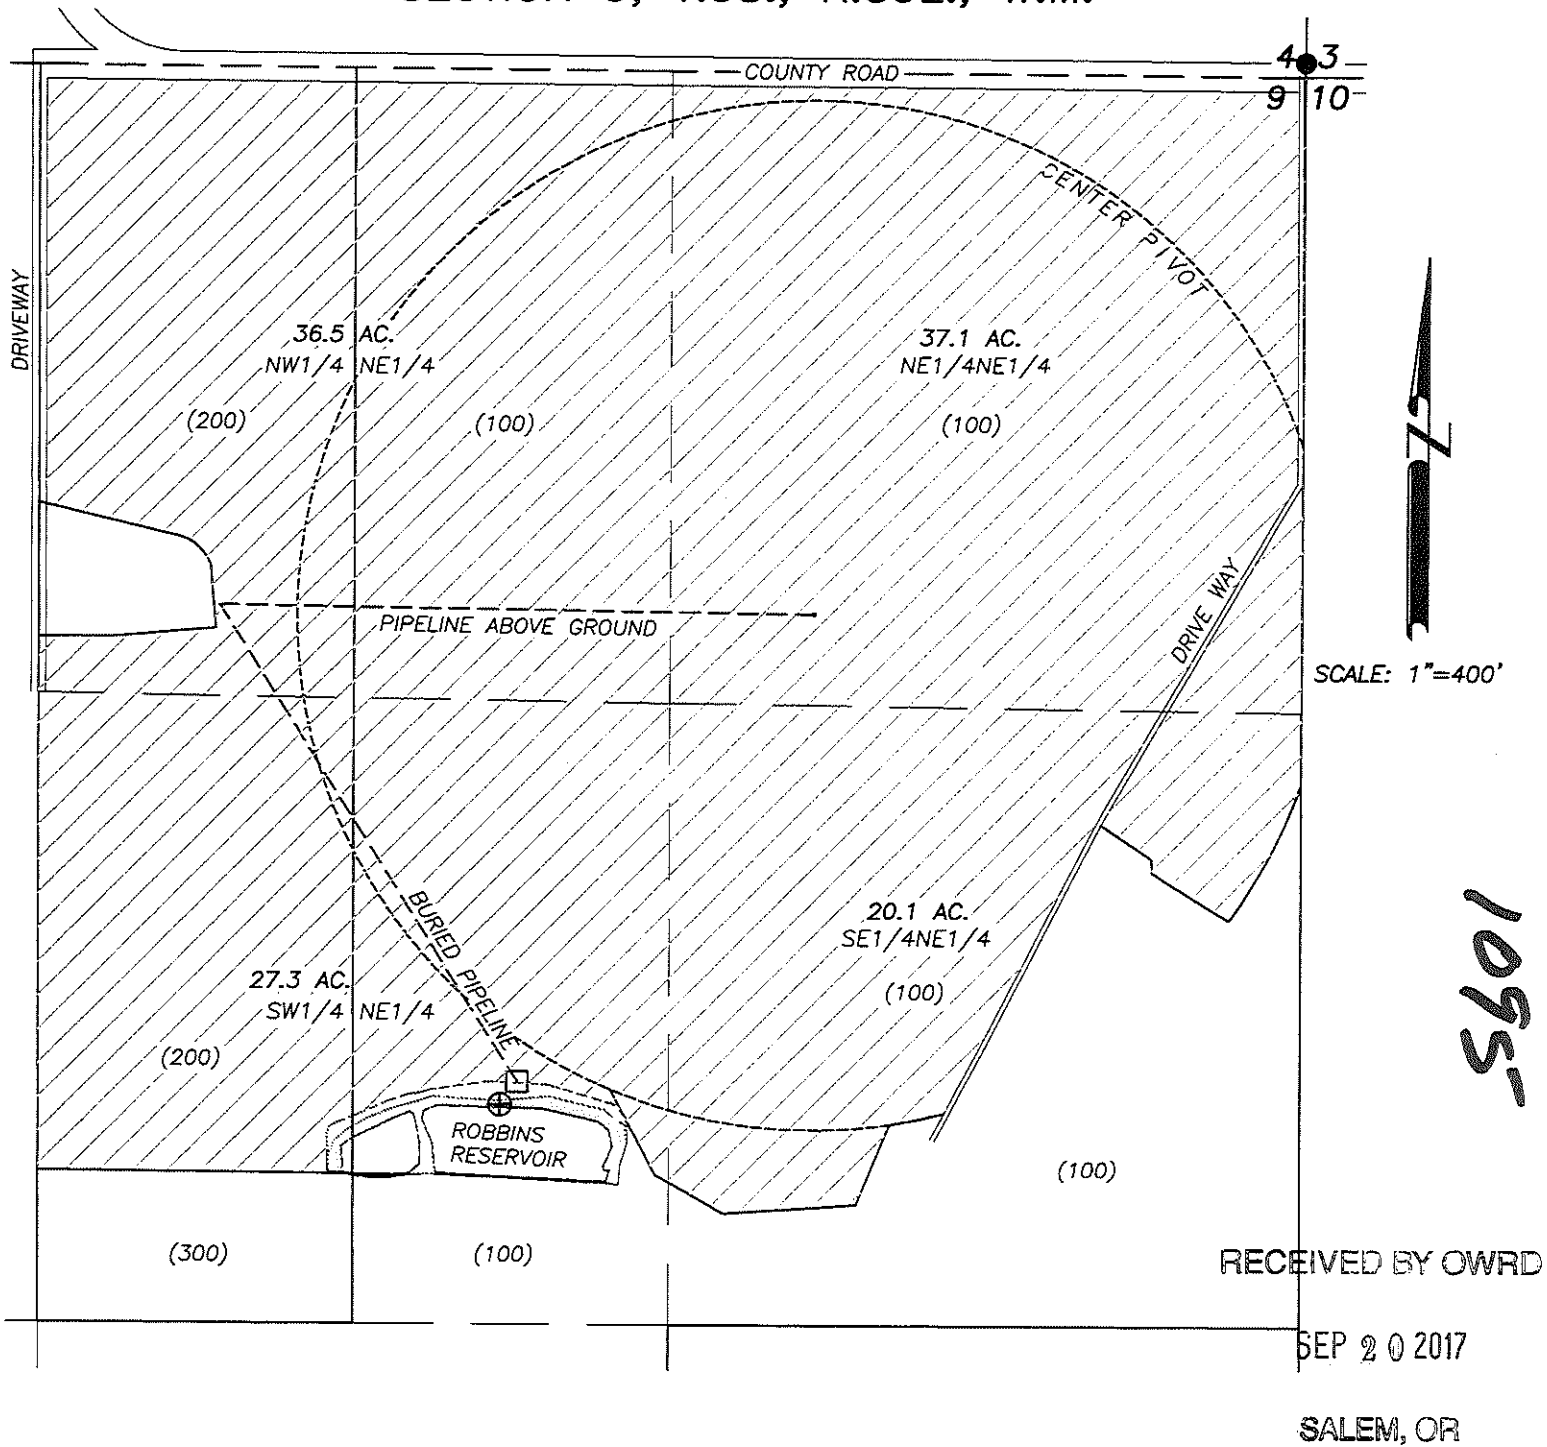

FINAL PROOF SURVEY

Under

PERMIT S-53815
APPLICATION S-84682

In Name Of
DENZIL ROBBINS

⊕ POD: MIDDLE CENTERLINE OF DAM AT OUTLET PIPE
IS 2140 FT. SOUTH & 1660 WEST FROM THE NE
CORNER SEC. 9

□ FLOW METER BEARS N40°15'E, 59.0 FT. FROM
MIDDLE CENTERLINE OF DAM

▨ PLACE OF USE - SUPPLEMENTAL IRRIGATION


--- PIPELINE

() TAX LOT

● FD. REFERENCE POINT: 5/8" REBAR AND CAP 30'
NORTH OF NE COR. SEC. 9

Prepared by: Robert D. Bagett, PLS, CWRE
217 N. Canyon Blvd.
John Day, Oregon 97845
(541) 575-1251

Date Surveyed: August 17, 2017.

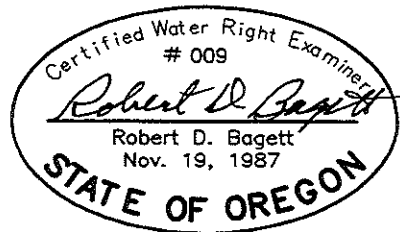

RENEWS: 12/31/2017

THIS MAP IS NOT INTENDED TO PROVIDE LEGAL DIMENSIONS OR
LOCATIONS OF PROPERTY OWNERSHIP LINES