


POINT OF DIVERSION AT INTAKE ON DAM
 North 3475' and West 452' from East 1/4 corner of Section 13,
 Township 3 South, Range 39 East of W.M.
 LATITUDE: 45°18'49.34799" N LONGITUDE: 117°52'20.29727" W

SCALE: 1"=600'


RECEIVED
 JUL 19 2018
 OWRD



Stored Water Surface Area: 1,041,465.15 sq. ft.
 Average water depth is 8.0 feet, which
 encloses 191.27 acre feet of water storage.

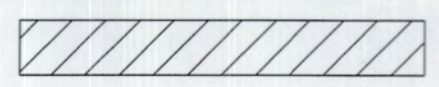

Old Grande Ronde River Channel Reservoir,
 Storing 191.27 Ac. Ft of water. Multiple
 Purpose use.

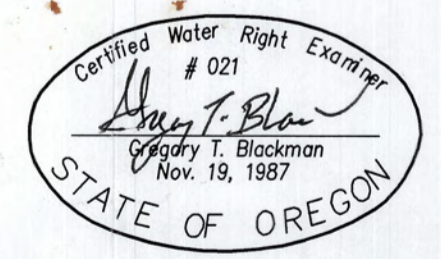

NOTE: The preparation of this map
 was for the purpose of identifying
 the location of the proposed water
 right and has no intent to provide
 dimensions or location of property
 ownership lines. Location information
 shown hereon was furnished by
 the applicant.

PROPERTY OWNERSHIP	
TL 3700	CONLEY FARMS LLC
TL 3600	CONLEY FARMS LLC
TL 3800	CONLEY FARMS LLC
T3S R 39 E WM	
TL 1600	CONLEY FARMS LLC
TL 5300	CONLEY FARMS LLC
T3S R 40 E WM	

NOTE:

The application for this project called the
 Reservoir the channel of an Unnamed Slough.
 Consultation of tax maps and Google Maps
 call the same area in storage the Old Channel
 of the Grande Ronde River. I choose to use
 the Old Channel of the Grande Ronde River
 for the Claim of Beneficial use mapping.

REVISED JULY 10, 2018
 June 10, 2018

CLAIM OF BENEFICIAL USE MAP FOR A RESERVOIR
 NAMED "OLD CHANNEL OF THE
 GRANDE RONDE RIVER" UNDER PERMIT R-14464
 FOR

DEE WAYNE JOHNSON
 (CONLEY FARMS LLC)
 BY

GREG BLACKMAN WATER RIGHTS
 126 RIDGE DRIVE
 LA GRANDE, OREGON 97850

APPLICATION NO. R- 86833
 PERMIT NUMBER R-14464

COBU MAP # 1147

COBU MAP # 1147