



**T5S R32E, WM
UMATILLA COUNTY, OR**

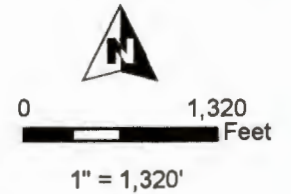

- Creek
- Reservoir
- Township
- Section
- Quarter Quarter
- Tax Lot

Outlet Location:
180' N, 1920' E of the NW Cor of the NESW Sec 35

RECEIVED
NOV 23 2020
OWRD

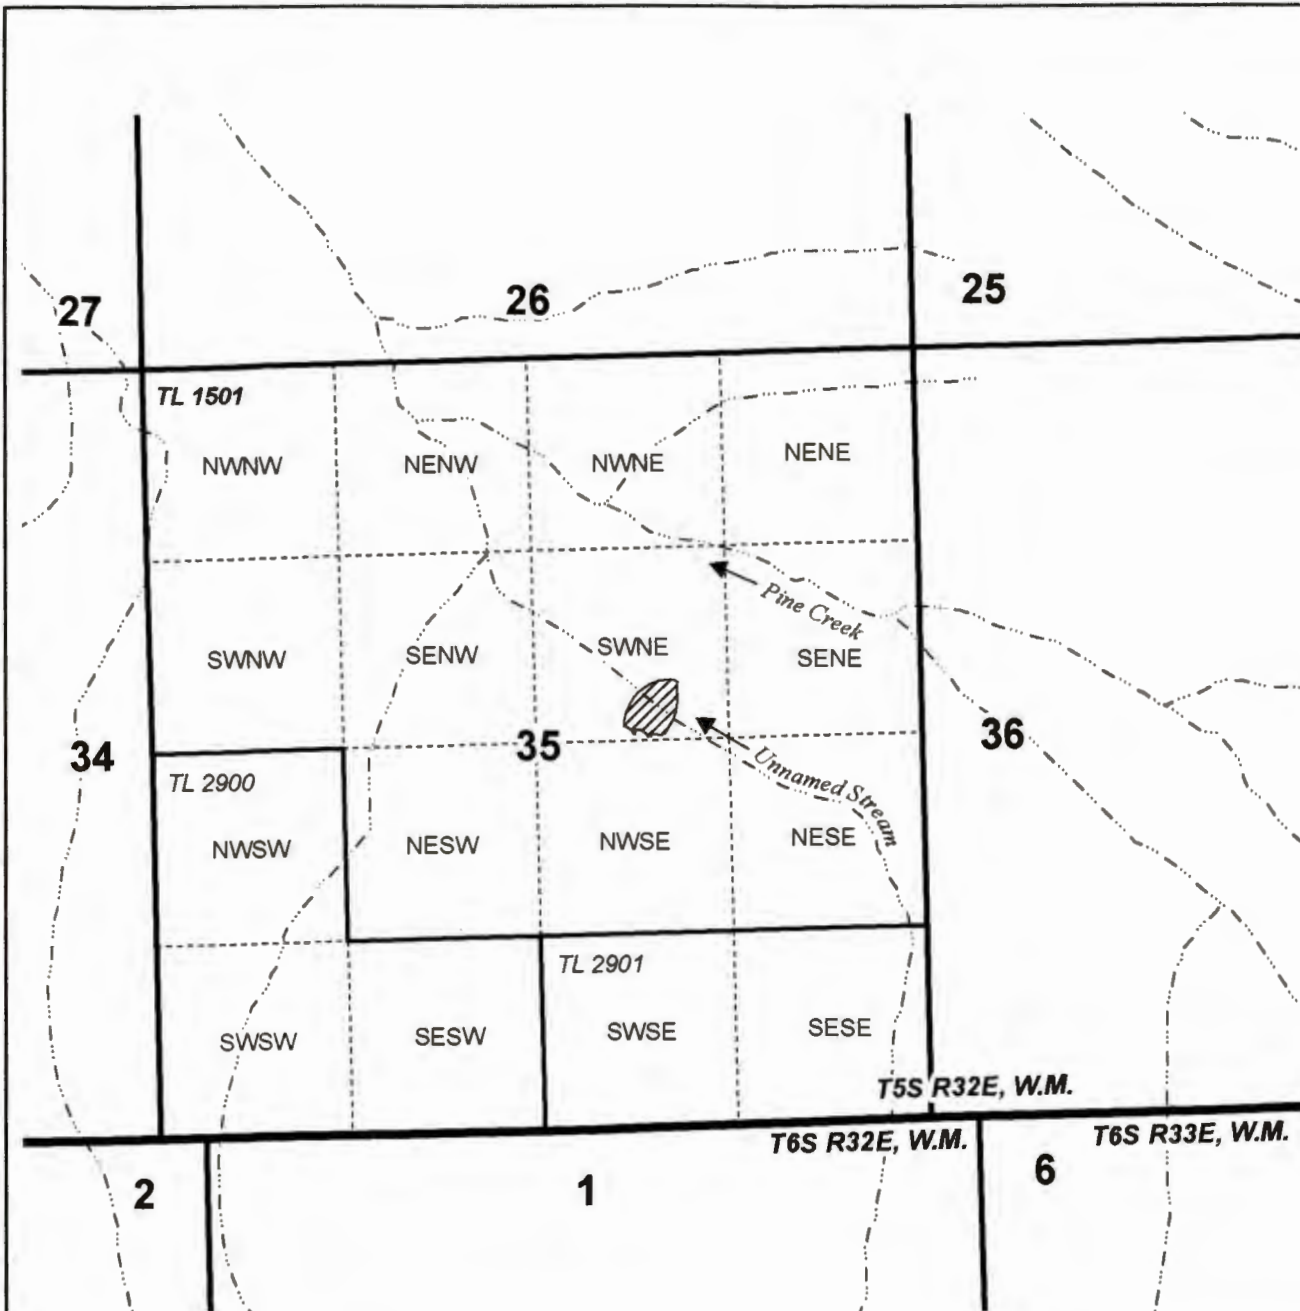

**CLAIM OF BENEFICIAL USE MAP
SPIN & MARTY, LLC**

Date: 10/28/2020

AP R-86865 Permit R-14495

This map is not intended
to provide legal dimensions
or locations of property
ownership lines.

WATER RIGHT SERVICES, LLC
PO BOX 1830, BEND, OR 97709
WWW.OREGONWATER.US CCB # 197121
johnshort@usa.com 541-389-2837