



T23S R32E, WM HARNEY COUNTY, OR

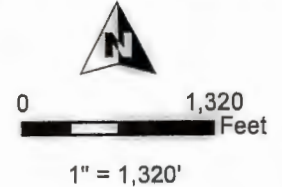


- Well & Meter
- Pipeline
- POU IR
- Section
- Quarter Quarter
- Tax Lot

Well Location:
#3- Burns Well B (HARN 52729/L-130032)
1190' S, 2820' E of NW Cor Sec 10

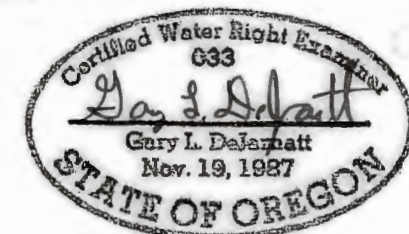

RENEWAL DATE 12/31/2021

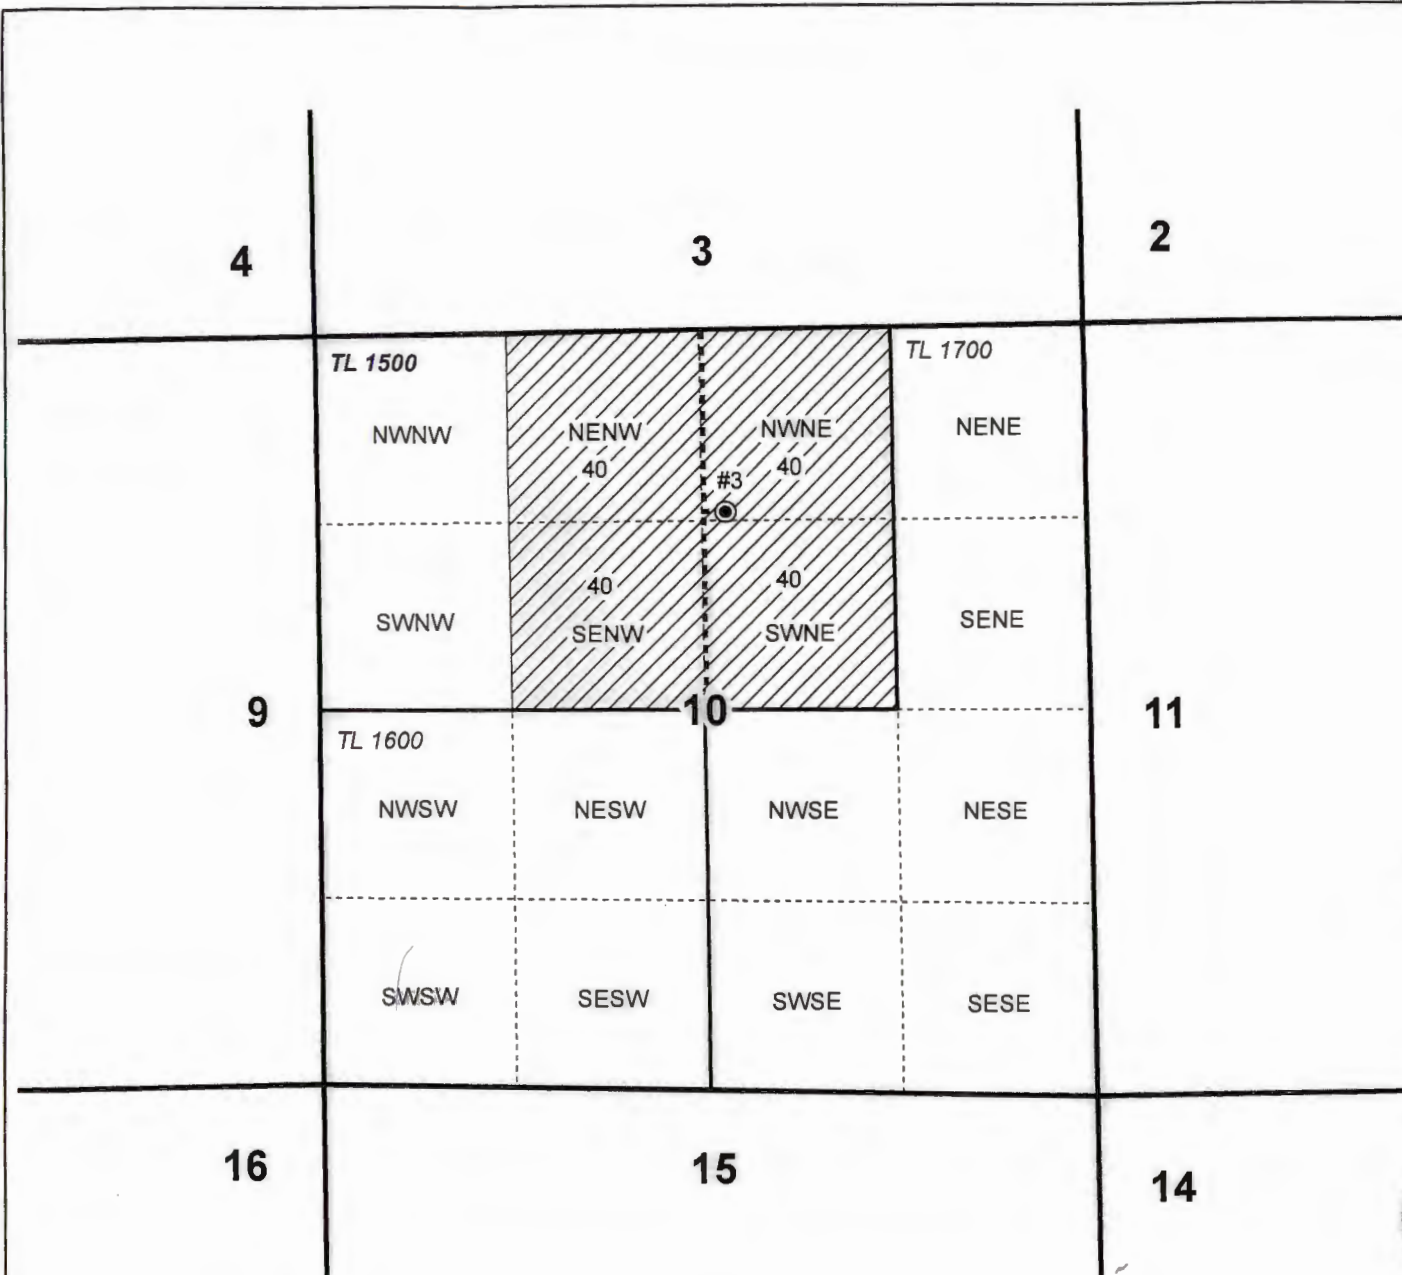

CLAIM OF BENEFICIAL USE MAP
Roger & Mindy Sheley

Date: 9/19/2020

Ap G-17791/T-13244

Permit G-18358

This map is not intended
to provide legal dimensions
or locations of property
ownership lines.

Project #20038

WATER RIGHT SERVICES, LLC
PO BOX 1830, BEND, OR 97709
WWW.OREGONWATER.US CCB # 197121
johnshort@usa.com 541-389-2837