

T. 29 S., R. 5 W., W. M.

SCALE: 1" = 400'

RECEIVED


JUN 27 2019

OWRD



POD IS 1025 FEET SOUTH AND
492 FEET WEST OF THE NE CORNER
OF SECTION 18, TOWNSHIP 29 SOUTH,
RANGE 5 WEST, WILLAMETTE MERIDIAN

THE PURPOSE OF THIS MAP IS TO IDENTIFY THE
LOCATION OF THE WATER RIGHT. IT IS NOT INTENDED TO
PROVIDE INFORMATION RELATIVE TO THE LOCATION OF
PROPERTY OWNERSHIP BOUNDARY LINES

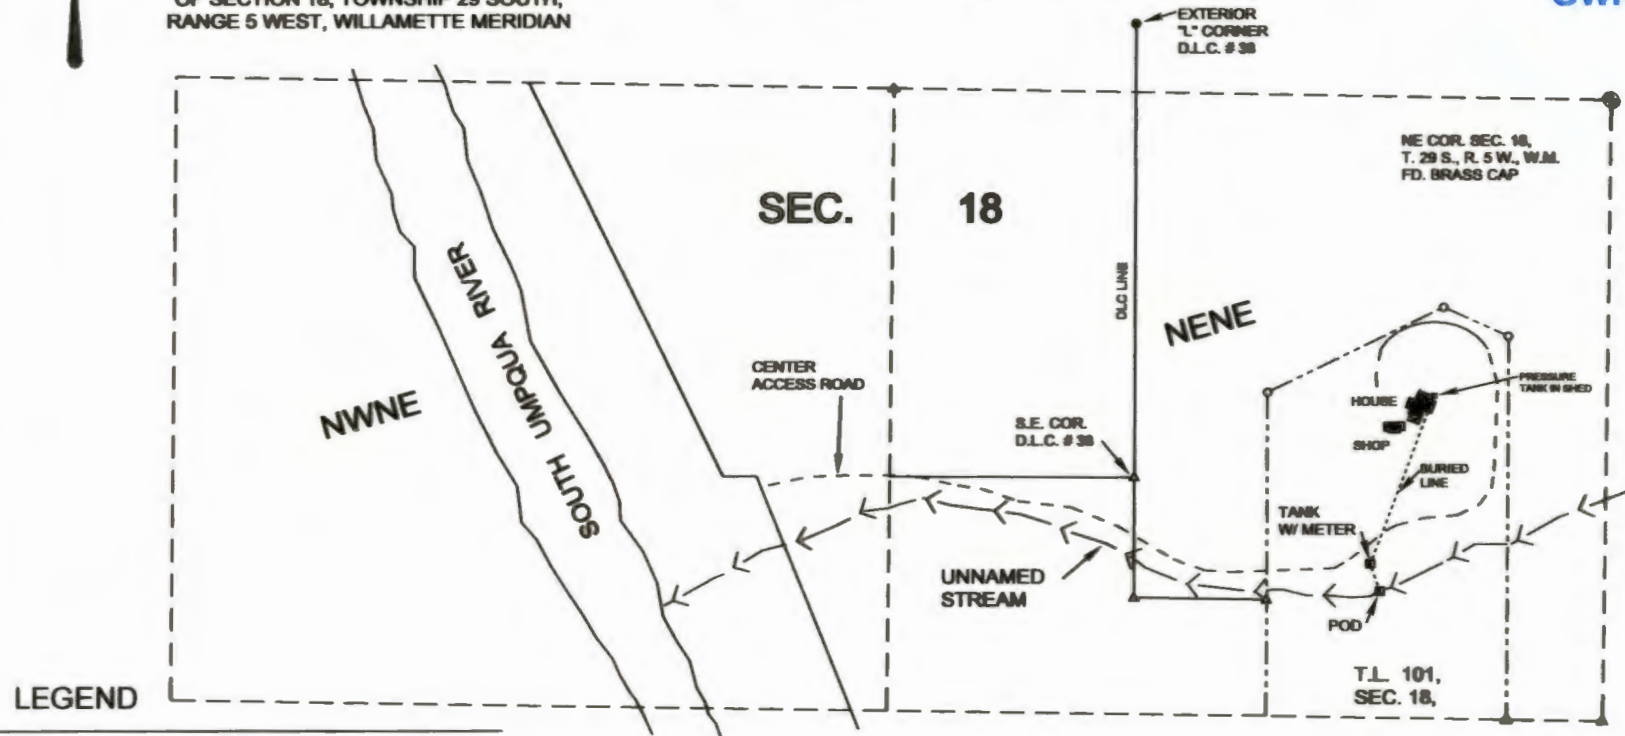

- ▲ COMPUTED POINT
- FD. PROPERTY CORNER
- COMPUTED DLC CORNER
- ⊙ GOVERNMENT CORNER

----- PROPERTY LINES

--- 40 LINES

FINAL PROOF SURVEY

UNDER

Application No. S-86825


Permit No. S-54457

IN NAME OF

TANWEER KHAN

SURVEYED APR. 04, 2019

by: R.F. BROWN

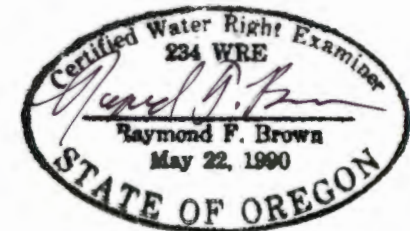

RENEWS 12/31/2019