

33 | 34

4 | 3

NW CORNER  
SEC. 3

1701'  
1425'

(Tax Lot 1500  
Map 15-10-03B)

NW NW  
POA 1

238'

0.73

6.42

1.9

371'


3.0

POA 2

Tax Lot 1501  
Map 15-10-03B

Section 3  
T15S, R10E, W.M.  
Deschutes Co. OR


SW NW

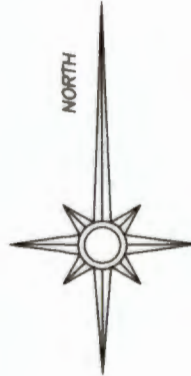

# **\*\*Revised\*\*** Claim of Beneficial Use

T-11754

7/17/2017

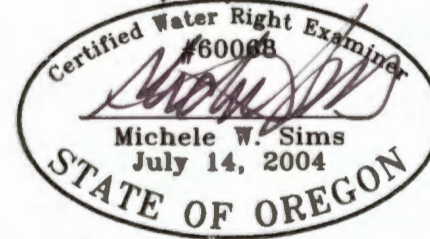

Renewal date: 6/30/2018

RECEIVED BY OWRD

JUL 20 2017

SALEM, OR



Water beneficially used under  
T-11754 (priority date  
12/17/1990)



Portion of Cert. 89674, priority  
date 12/17/1990 not included in  
transfer

Property line



GRAPHIC SCALE - FEET

This map is for the purpose of identifying the location of the water right. It is not intended to provide legal dimensions or locations of property ownership lines.