


This map is not intended to provide legal dimensions or locations of property ownership lines.

Section 6, T13S R6W, W.M.

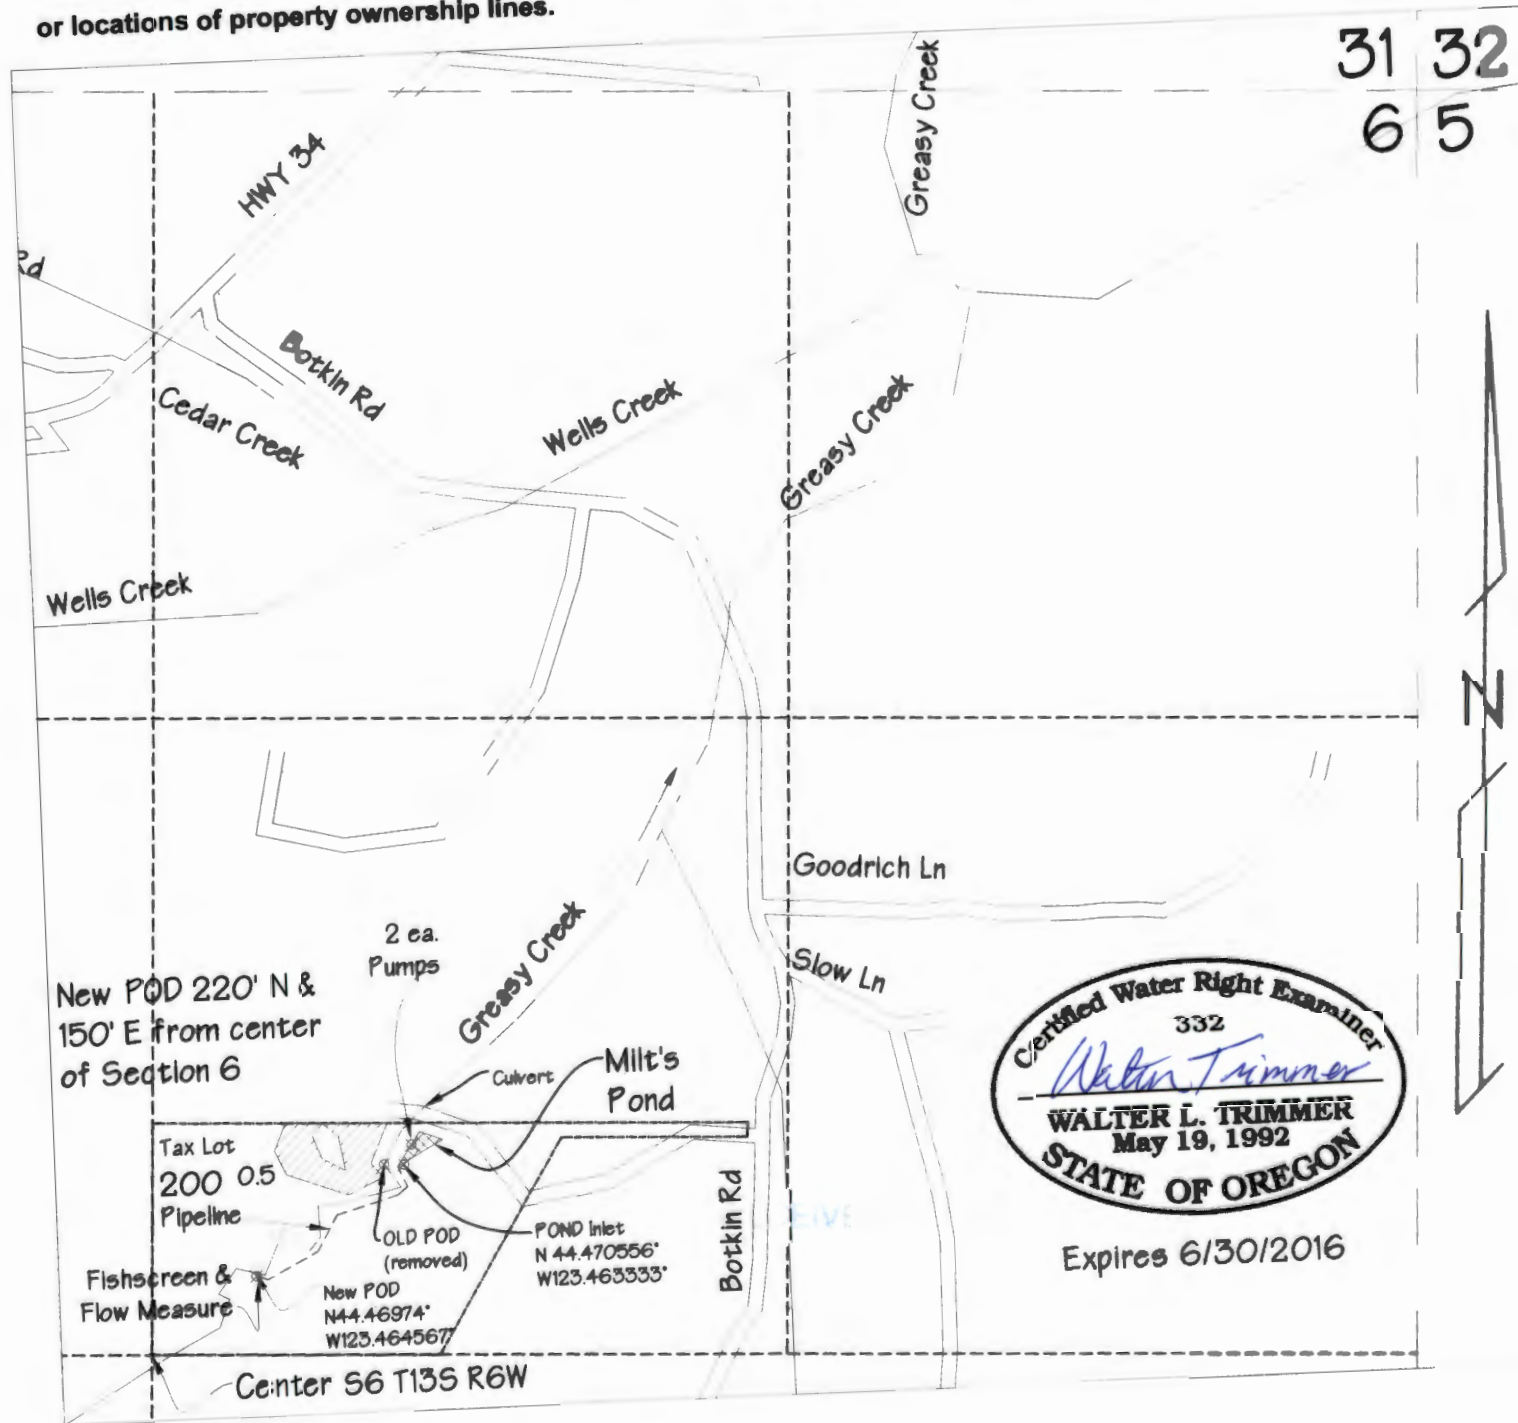

Final Proof Survey
Transfer T-11495
In the name of
Weske-Windflower
Revocable
Living Trust

Irrigation

Certificate 42989
Permit #36801


Prepared by
Walter L. Trimmer
CWRE #332
Trimmer Engineering Inc.
3924 NW Walnut Place
Corvallis, OR 97330
541-754-2819

Scale 1" = 400'

April 29, 2016

Layout: IFPS
File: Weske.dwg
Based on
USGS Wren Quad

DWG 1 of 1

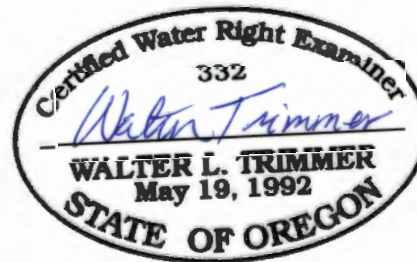

Expires 6/30/2016