


T. 22S., R20E21E, W.M.

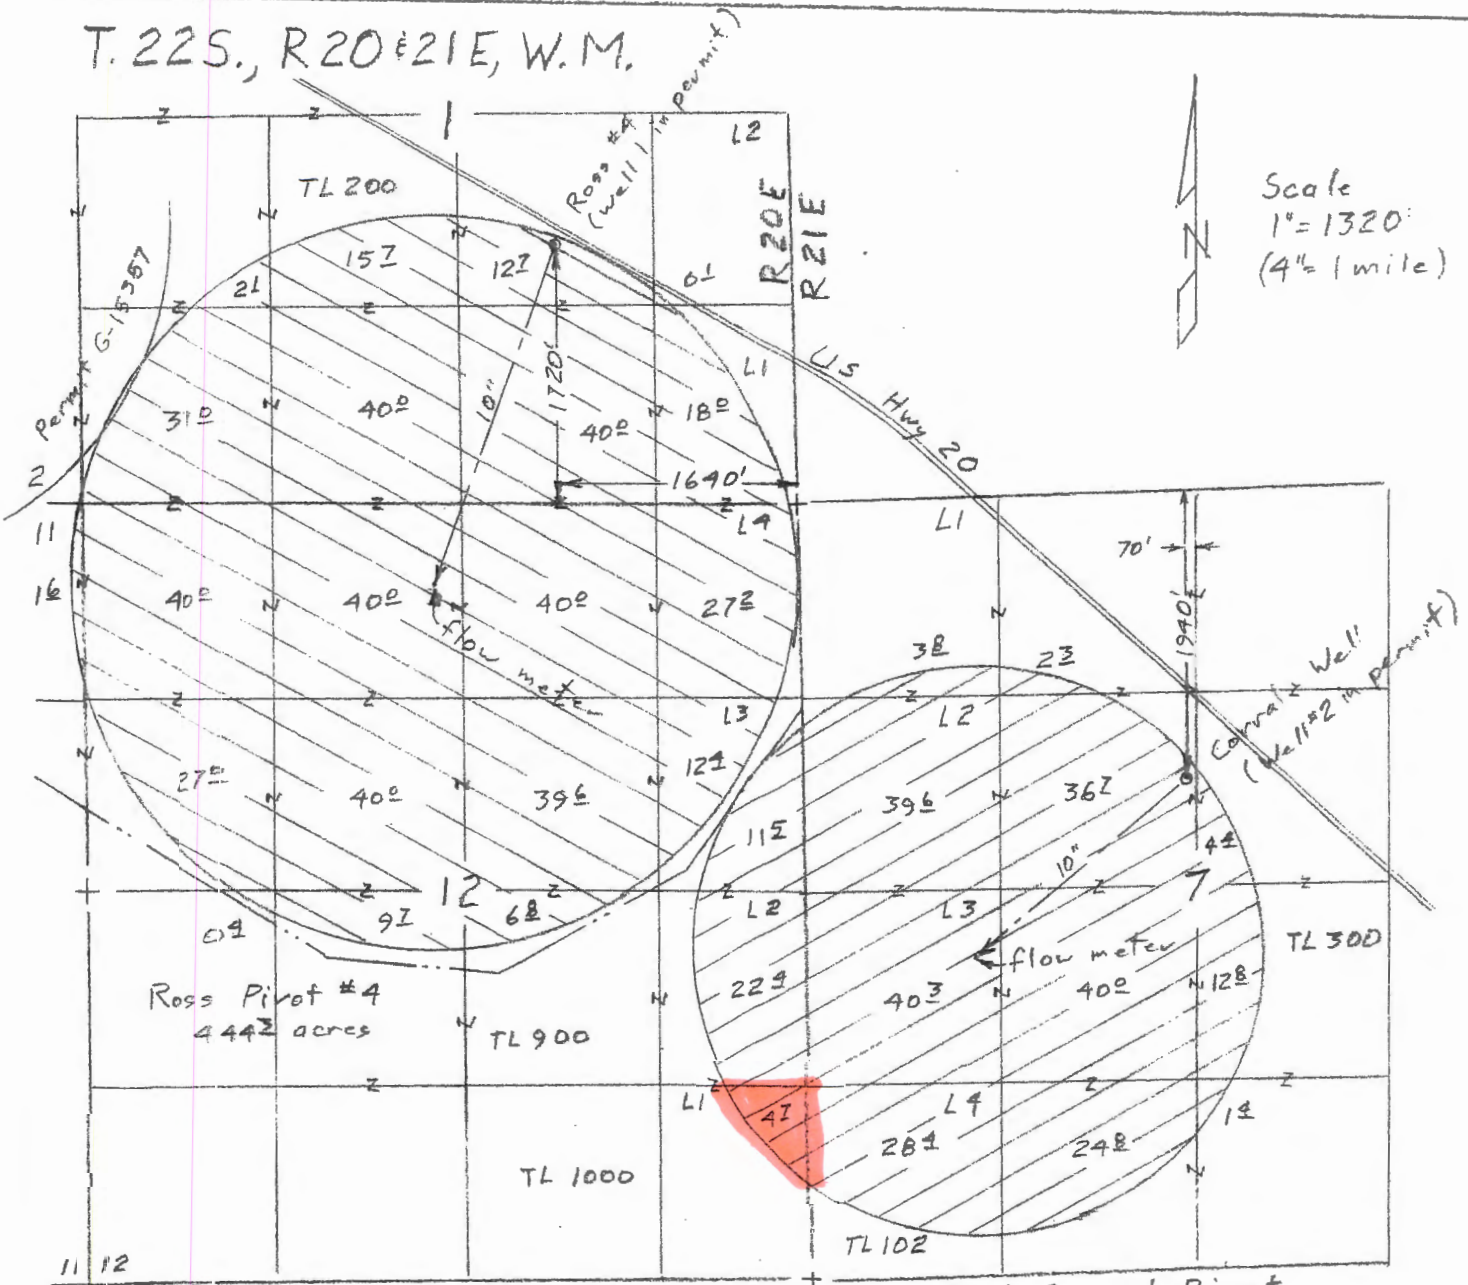

Surveyed Oct 7, 2014

Roth Corral Pivot  
2731 acres

App G-16123  
Per G-15706

Claim of Beneficial Use Map  
for  
Robert Ross & Stephen Roth



This map is for the purpose of locating a water right only and has no intent to provide legal dimensions or the location of property lines.

**ESTES SURVEYS, LLC**  
 PO Box 17519      60382 Arnold Rd  
 Salem, OR 97305-7519      Bend, OR 97702  
 (503) 865-7593      (541) 382-7317