

## T.6S., R.2W., W.M.

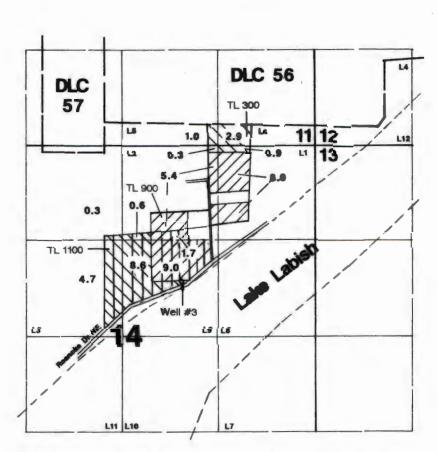

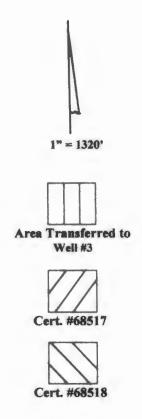

Well #3 is located 1890' S & 1838' W from the NE corner of Section 14.

## **Final Proof Survey**

In the Name of

## Clayton L. & Rhonda R. McCullough

Transfer #: T-9495

Surveyed May 24, 2019 by JM Schuette

This Map was Prepared for the Purpose of Identifying the Location of a Water Right Only and is Not Intended to Provide Legal Dissessions or Location of Property Ownership Lines.

