
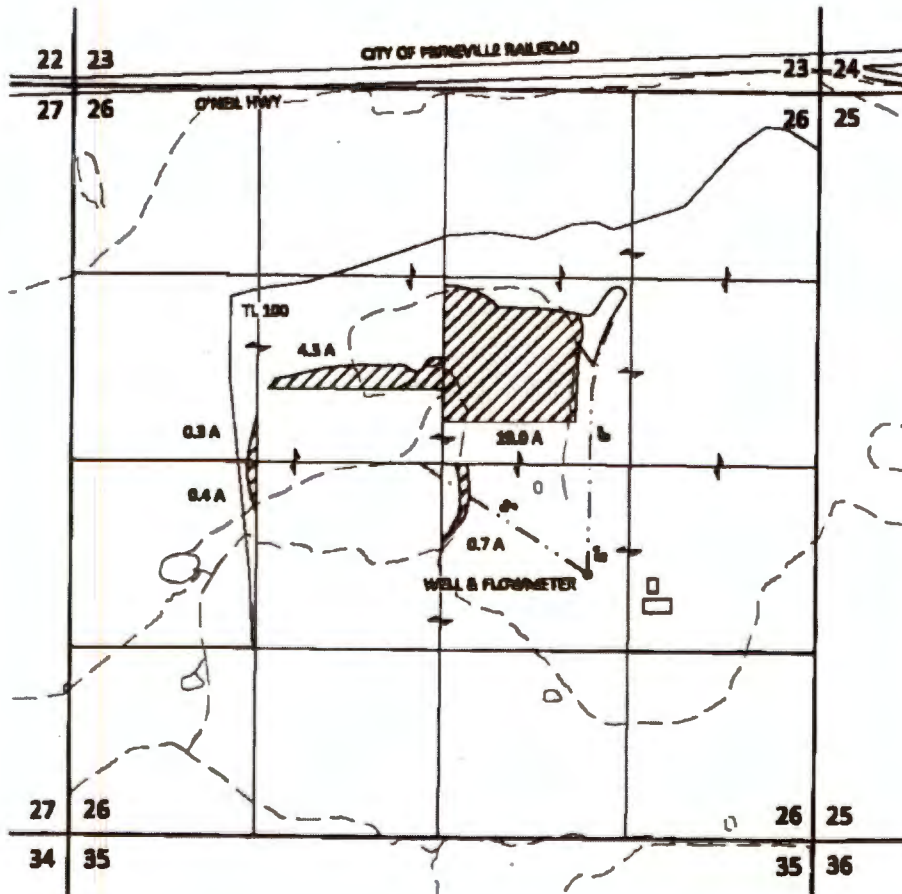


Section 26, T14S, R14E, W.M.,
Crook County, Oregon

Transfer T-8897
CLAIM OF BENEFICIAL USE MAP
David M. and Cindy M. Townsend

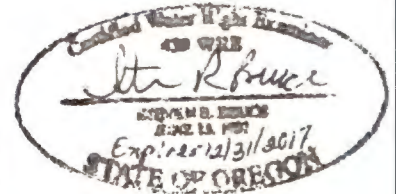

RECEIVED
SEP. 08 2017
OWRD

WELL LOCATION: 750 FT S AND 1640 FT W
FROM EAST QUARTER CORNER SECTION 26, T14S, R14E, W.M.

USE THIS MAP FOR PLACE
OF USE ONLY FOR T-8897
CONFIRMING CERTIFICATE
wrđ 3/4/2021

EXPLANATION



PLACE OF USE - 24.7 ACRES
PRIORITY: 5/31/1985



WELL & FLOWMETER



PIPE

SCALE



1 INCH = 1320 FEET

Site Inspection Conducted:
June 23 & August 15, 2017

September 1, 2017

This map is not intended to provide legal
dimensions or locations of property
ownership lines

SKOOKUM

WATER ASSOCIATES INC


1626 VICTORIAN WAY
EUGENE, OR 97401
(503) 319-8926

Figure 1

TOWNSHIP 14 SOUTH, RANGE 14 EAST, W.M.

**USE THIS MAP FOR WELL LOCATION ONLY FOR
T-8897 CONFIRMING CERTIFICATE - wrd 3/4/2021**


Section 26

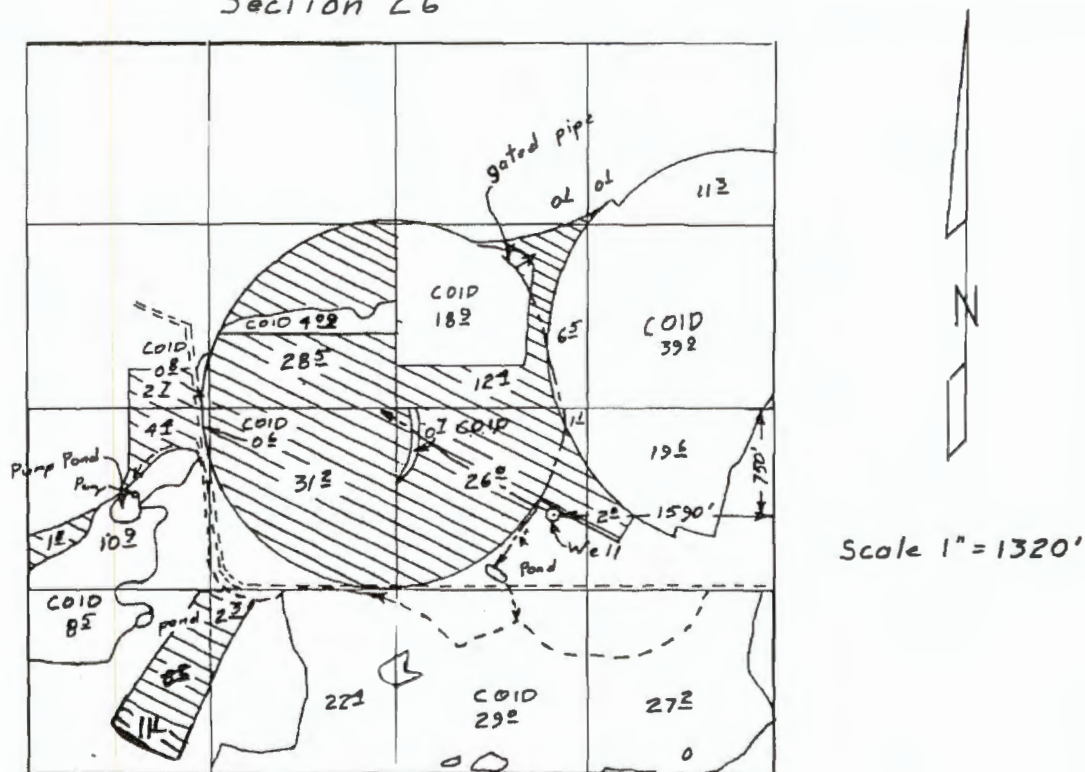

Surveyed August 16, 2000

Claim of Beneficial Use Map
for
LARK RANCH

App G-14023
Per G-13009

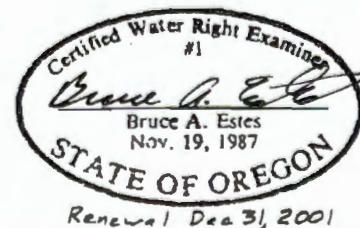

This map is for the purpose of
locating a water right only
and has no intent to provide
legal dimensions or the location
of property lines.

ESTES SURVEYS

PO Box 17519
Salem, OR 97305-7519
(503) 585-7593

60382 Arnold Rd
Bend, OR 97702
(541) 382-7391

WRD AC 9-27-10