


THIS MAP IS NOT INTENDED TO PROVIDE LEGAL DIMENSIONS OR LOCATIONS OF PROPERTY OWNERSHIP LINES.

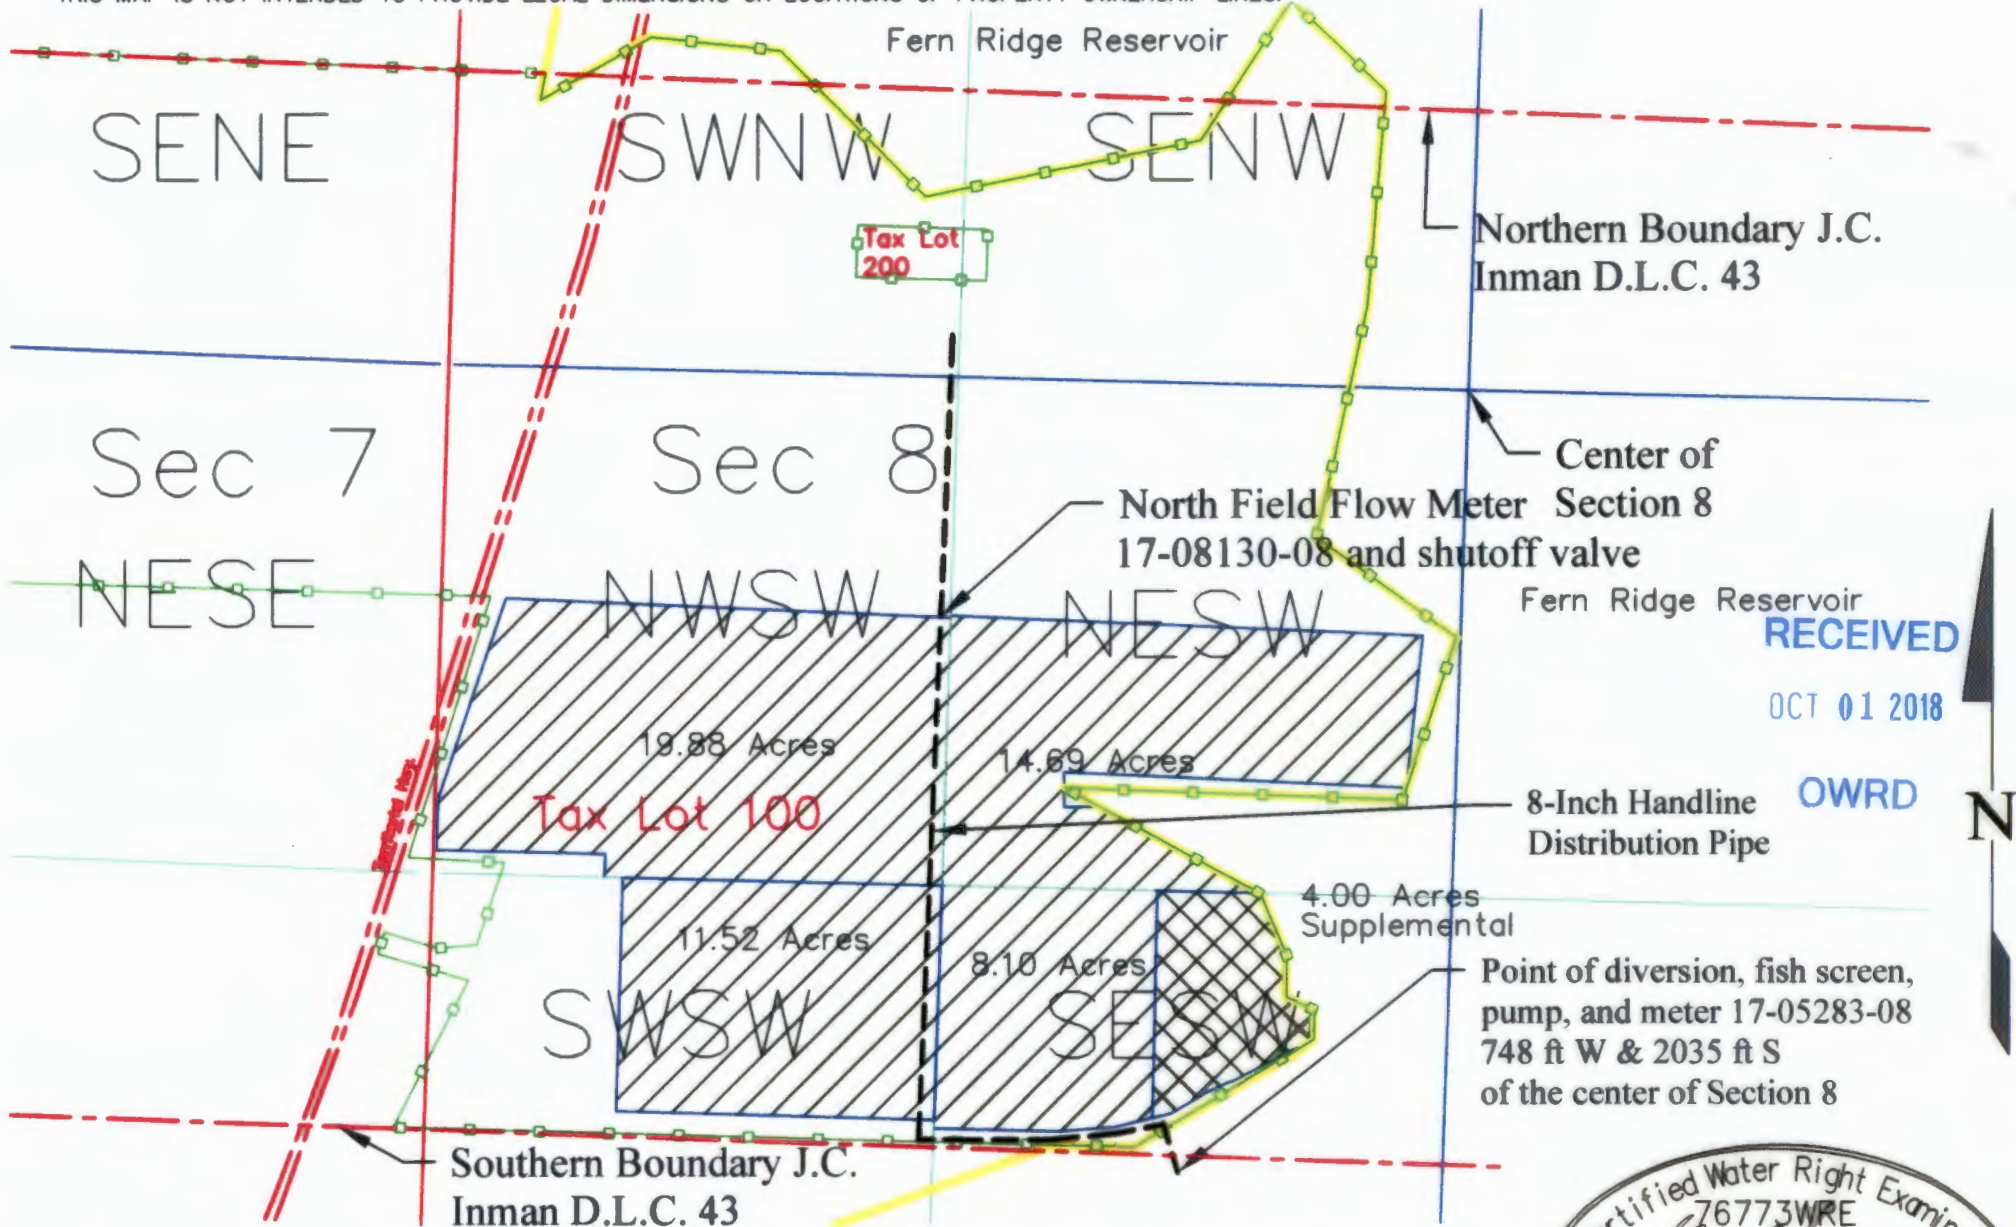

RECEIVED  
OCT 01 2018

OWRD

Claim Map for Application S86040, Permit S54413  
Township 17 S Range 5 W Section 8  
Lane County Tax Lot 17-05-08-00-00100

Township	Range	Section	Qtr-Qtr	Qtr	DLC	Acres		Total
						Primary	Secondary	
17	5	8	NW	SW	43	19.88		19.88
17	5	8	SW	SW	43	11.52		11.52
17	5	8	NE	SW	43	14.69		14.69
17	5	8	SE	SW	43	8.10	4.00	12.10
Total						54.19	4.00	58.19

Area irrigated under permit S54413

Quarter Quarter Lines  
Reservoir Boundary  
Tax Lot Boundaries  
DLC Lines  
Section Lines  
Quarter Section Lines


Certified Water Right Examiner  
76773WRE  
*Steven I Recca*  
Steven I Recca  
June 29, 2007  
STATE OF OREGON

EXPIRATION DATE: 12/31/18

THIS MAP IS NOT INTENDED TO PROVIDE LEGAL DIMENSIONS OR LOCATIONS OF PROPERTY OWNERSHIP LINES.



Claim Map for Application S86040, Permit S54413  
 Township 17 S Range 5 W Section 8  
 Lane County Tax Lot 17-05-08-00-00100

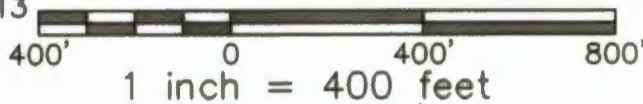

Township	Range	Section	Qtr-Qtr	Qtr	DLC	Acres		Total
						Primary	Secondary	
17	5	8	NW	SW	43	19.88		19.88
17	5	8	SW	SW	43	11.52		11.52
17	5	8	NE	SW	43	14.69		14.69
17	5	8	SE	SW	43	8.10	4.00	12.10
Total						54.19	4.00	58.19

 Area irrigated under permit S54413

 Quarter Lines


 Reservoir Boundary

 Tax Lot Boundaries

 DLC Lines

 Section Lines

 Quarter Section Lines

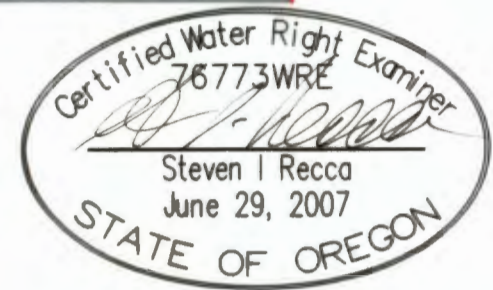

EXPIRATION DATE: 12/31/18