

T25S R36E, WM
HARNEY COUNTY, OREGON




0 1,320 Feet
 1" = 1,320'

- Well
- Ditch
- Pipeline
- POU IR
- Section
- Tax Lot
- Quarter Quarter

Well Location:

Well 2 (HARN 52598/L-123038:
 1,030' N, 70' E of
 SW COR Sec 16

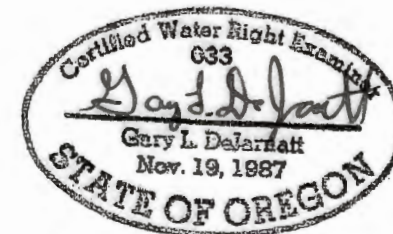

RENEWAL DATE 12/31/2021

CLAIM OF BENEFICIAL USE MAP
C Bar S, LLC

AP G-17202/T-12569

PERMIT G-17940

NOTE: THIS MAP IS NOT INTENDED TO
 PROVIDE LEGAL DIMENSIONS OR LOCATIONS
 OF PROPERTY OWNERSHIP LINES.

PROJECT #20041

Date: 8/20/2020

WATER RIGHT SERVICES, LLC
 PO BOX 1830, BEND, OR 97709
 CCB# 197121 www.oregonwater.us
 541-389-2837 JOHNSHORT@USA.COM

