SECTIONS 33 & 34, TWP.4 S. RANGE 12 E. W.M.
AND SECTION 3, TWP.5 S. RANGE 12 E. W.M.
WASCO COUNTY, OREGON

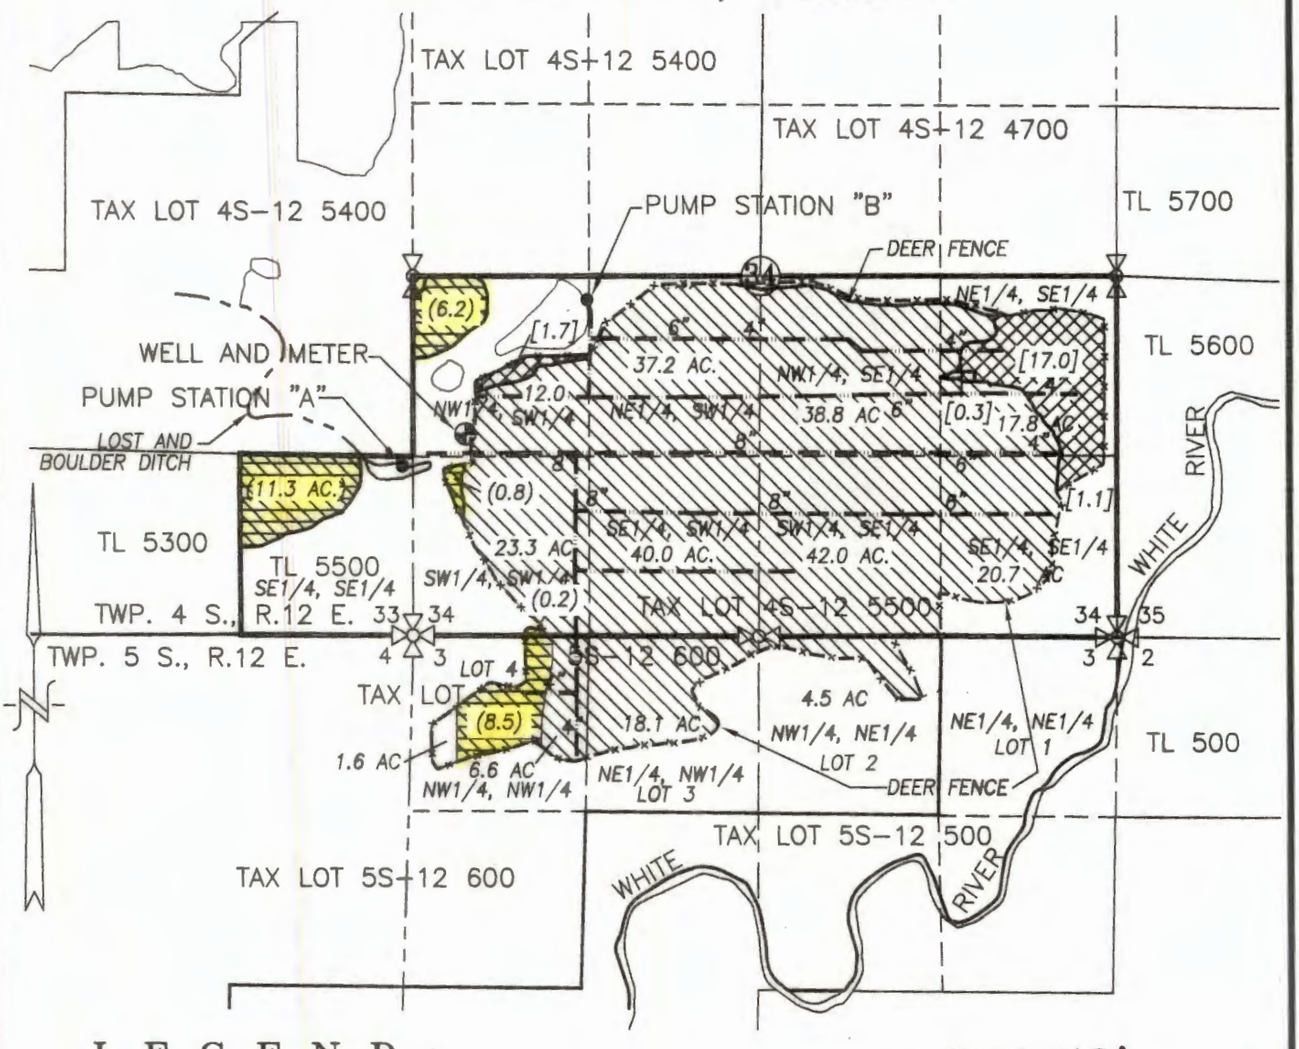

L E G E N D :

- TRANSFER 11718 AREA = [20.1] ACRES
- TRANSFER 12014 AREA = (27.0) ACRES
- SUPPLEMENTAL APPLICATION AREA = 308.1 ACRES
- EXISTING WELL: 1,500' N. & 395' E. OF SW CORNER SECTION 34
- EXISTING PUMP STATION
- EXISTING IRRIGATION MAIN LINE

ORIGINAL WITH APPLICATION G-18152

RECEIVED
JUN 11 2018
OWRD

CLAIM OF BENEFICIAL USE MAP

SCALE: 1"= 1320'

0' 660' 1320' 2640'

TRANSFER No. 11718 AND 12014

APPLICATION No. G-18152

PERMIT No. G-17679

IN THE NAME OF:

DOG RIVER ORCHARDS AND
NORTHWEST FARM CREDIT SERVICES, FLCA

DATE: MAY 17, 2018

BY: TENNESON ENGINEERING CORP.
3775 CRATES WAY
THE DALLES, OREGON. 97058
PH. 541-296-9177
FAX 541-296-6657

CERTIFIED WATER RIGHT EXAMINER
132
LARRY M. TOLL
NOV. 19, 1987
STATE OF OREGON

EXPIRES: 06/30/2020

NOTE:
"THIS MAP IS NOT INTENDED TO PROVIDE LEGAL DIMENSIONS OR LOCATIONS OF PROPERTY OWNERSHIP LINES."

W.O. #14076wr