

CLAIM OF BENEFICIAL USE MAP

FOR: BRADFORD & CRISTA RACKLEFF

BY: NATHAN REED, PE, CWRE

T26S, R5W, W.M. SECTION 23 DLC 41

APPLICATION NO. S-88572


PERMIT NO. S-55215

DATE SURVEYED: JANUARY 4, 2021



RECEIVED SCALE: 1" = 400'

JAN 11 2021

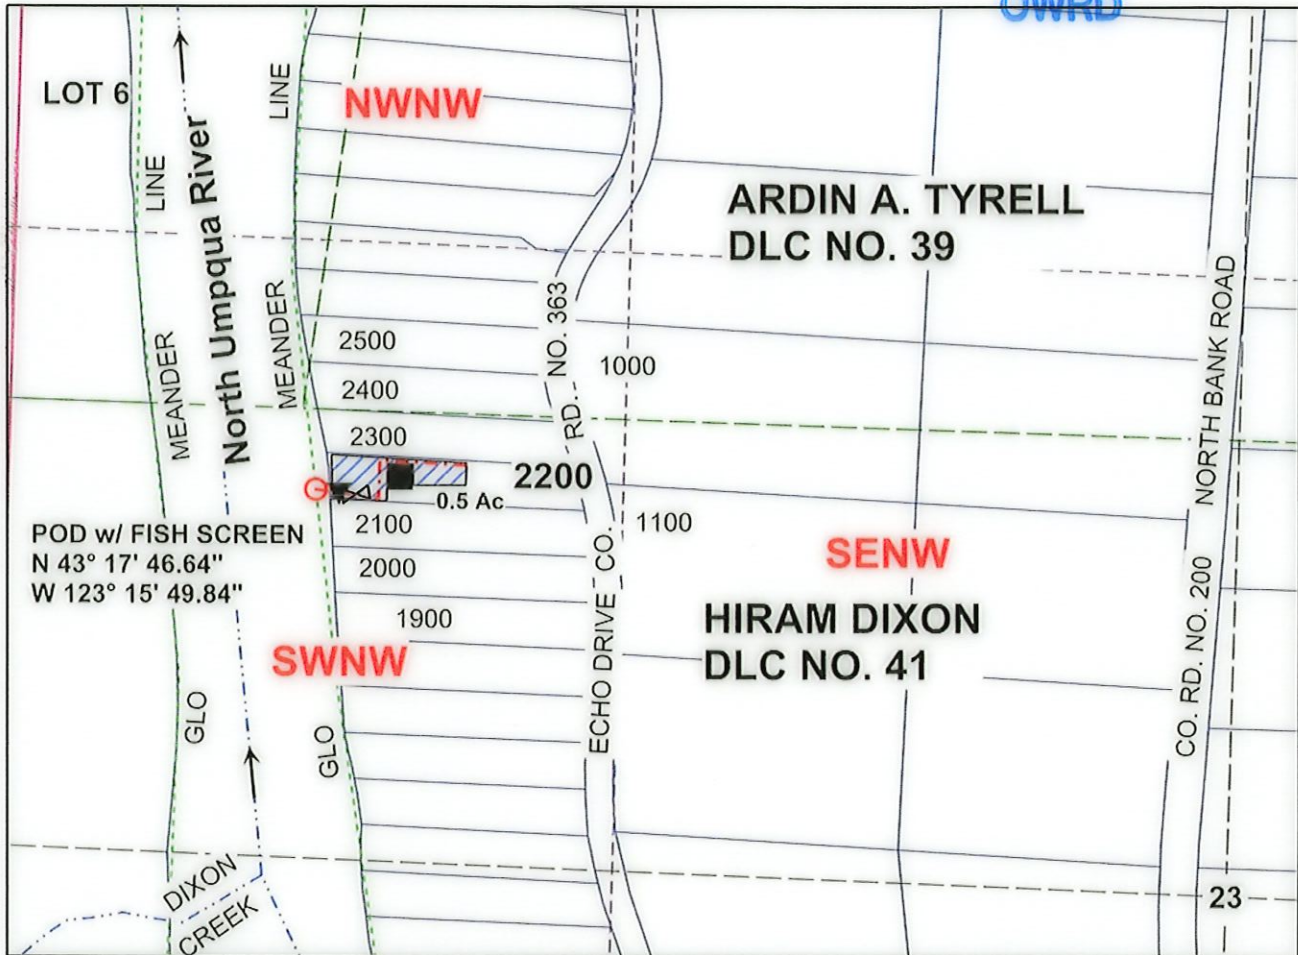

POD IS LOCATED 776 FEET NORTH AND 658 FEET EAST FROM THE W1/4 CORNER, SECTION 23 AS PROJECTED IN DLC NO. 41.

Legend

	Stream		Flow Restrictor		DLC
	POD		House		Quarter
	PUMP		Flow arrow		Sixteenth
	Pipeline		Meander		Parcels

MAP PREPARED FOR:
BRADFORD & CRISTA RACKLEFF
PO BOX 1444
ROSEBURG, OR 97470



THE PURPOSE OF THIS MAP IS TO IDENTIFY THE LOCATION OF THE WATER RIGHT. IT IS NOT INTENDED TO PROVIDE INFORMATION RELATIVE TO THE LOCATION OF PROPERTY OWNERSHIP BOUNDARY LINES.

MAP PREPARED BY:
NATHAN R. REED, PE, CWRE
157 WEST BODIE STREET
ROSEBURG, OR 97471