**PECEIVED** 

PSHS OF STYAM


SHW!

CLAIM OF BENEFICIAL USE MAP

TO SHOW PLACES OF USE AND POINTS OF APPROPRIATION FOR TRANSFER T-17733. 11733 ACINED RATTLESNAKE CREEK LAND & CATTLE, LLC

RECEIVED MAY 2 0 2021

OWRD

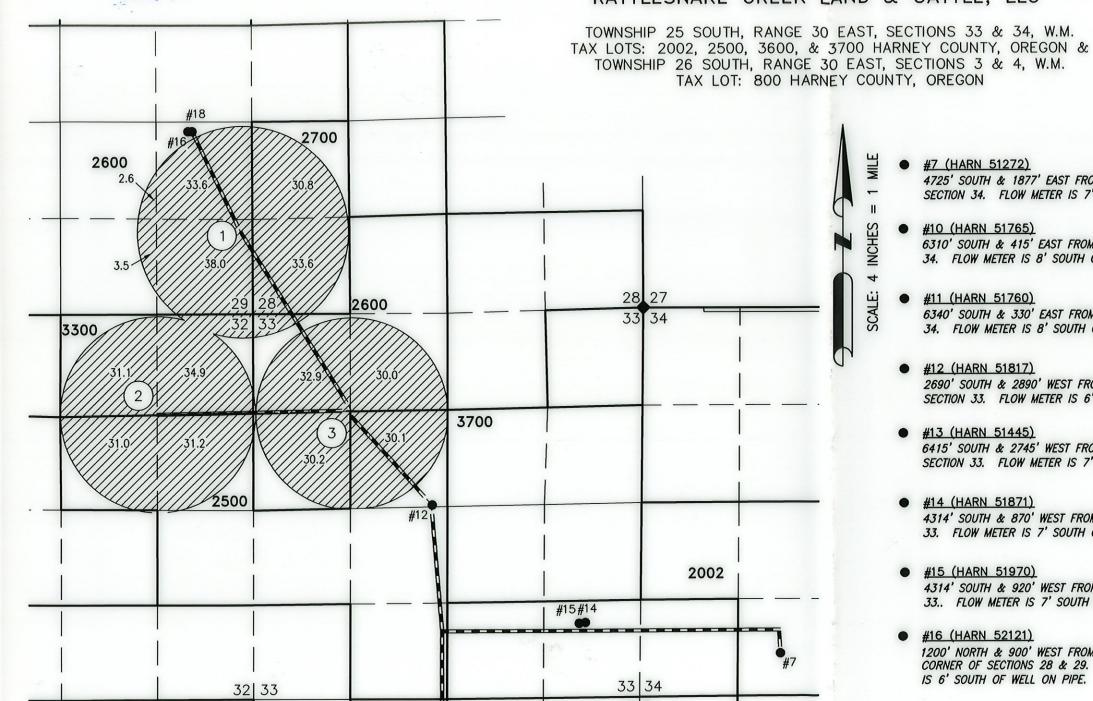

900

L3

L4

#7 (HARN 51272) 4725' SOUTH & 1877' EAST FROM THE NW CORNER SECTION 34. FLOW METER IS 7' WEST OF WELL ON PIPE.

#10 (HARN 51765) 6310' SOUTH & 415' EAST FROM THE NW CORNER SECTION 34. FLOW METER IS 8' SOUTH OF WELL ON PIPE.

#11 (HARN 51760) 6340' SOUTH & 330' EAST FROM THE NW CORNER SECTION 34. FLOW METER IS 8' SOUTH OF WELL ON PIPE.

#12 (HARN 51817) 2690' SOUTH & 2890' WEST FROM THE NE CORNER SECTION 33. FLOW METER IS 6' NORTH OF WELL ON PIPE.

#13 (HARN 51445) 6415' SOUTH & 2745' WEST FROM THE NE CORNER SECTION 33. FLOW METER IS 7' NORTH OF WELL ON PIPE.

#14 (HARN 51871) 4314' SOUTH & 870' WEST FROM THE NE CORNER SECTION 33. FLOW METER IS 7' SOUTH OF WELL ON PIPE.

#15 (HARN 51970) 4314' SOUTH & 920' WEST FROM THE NE CORNER SECTION 33.. FLOW METER IS 7' SOUTH OF WELL ON PIPE.

#16 (HARN 52121) 1200' NORTH & 900' WEST FROM THE S 1/16 CORNER OF SECTIONS 28 & 29. FLOW METER IS 6' SOUTH OF WELL ON PIPE.

• #17 (HARN 52154) 6300' SOUTH & 440' EAST FROM THE NW CORNER SECTION 34. FLOW METER IS 8' SOUTH OF WELL ON PIPE.

 #18 (HARN 52170) 1200' NORTH & 850' WEST FROM THE S 1/16 CORNER OF SECTIONS 28 & 29. FLOW METER IS 8' EAST OF WELL ON PIPE.

ALUMINUM CAPPED SECTION CORNER MONUMENT

BURIED 8 OR 10 INCH STEEL PIPE

393.5 ACRES PRIMARY IRRIGATION FROM WELLS 7, 10-13, T-11733, AS SHOWN



RENEWAL DATE: 12/31/2022

THIS MAP IS FOR THE PURPOSE OF LOCATING A WATER RIGHT ONLY AND HAS NO INTENT TO PROVIDE LEGAL DIMENSIONS OR THE LOCATION OF PROPERTY LINES

PREPARED FOR:

#11\_#17 L4

#10 800

L3

L1

ANDY ROOT 524 HIGHWAY 20 N HINES, OR 97738

PREPARED BY:



ALL POINTS ENGINEERING AND SURVEYING, INC. P.O. BOX 767 TERREBONNE, OR 97760 (541) 548 - 5833www.APEandS.com