







**Claim of Beneficial Use
T-10327
Liskey Farms Inc.**

Industrial, Commercial, Fish Culture

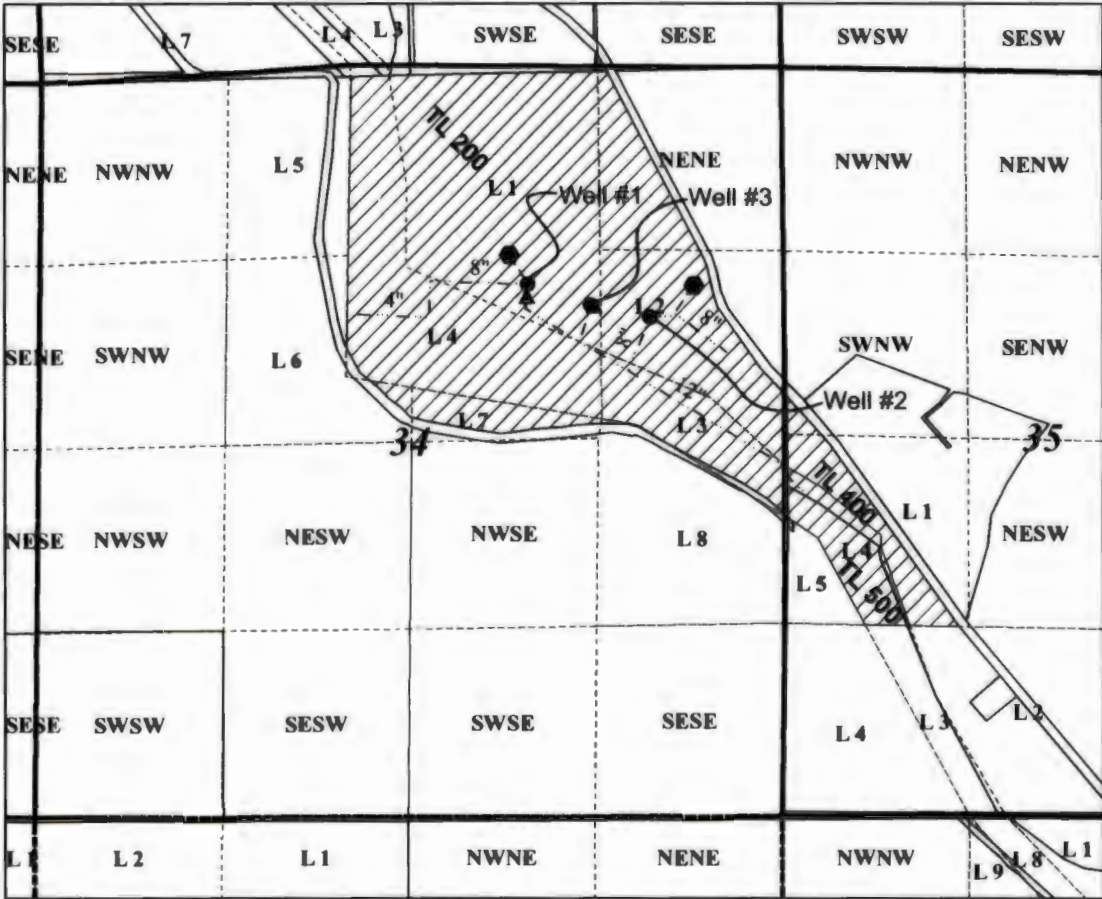

POA location of wells
 Well #1 - 1520 ft South & 1780 ft West Fm the NE Cor. Section 34
 Well #2 - 1760 ft South & 930 ft West Fm the NE Cor. Section 34
 Well #3 - 1640 ft South & 1325 ft West Fm the NE Cor. Section 34
 All in T40S, R9E, Section 34, WM

Legend

-  Area of Use
-  Pipeline
-  Wells
-  Truck Fill
-  Storage tank



1 inch = 1,320 feet

Note: This map is not intended to provide legal dimensions or locations of property ownership lines.

