



T27S R34E, WM, HARNEY COUNTY, OR

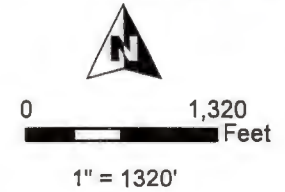

- Well & Meter
- Pipeline
- POU IR 9-27-2012 Priority
- Township
- Section
- Quarter Quarter
- Tax Lot

Well Location:
HARN 52818/L-133021
1530' S, 1330' W of NE Cor Sec 6

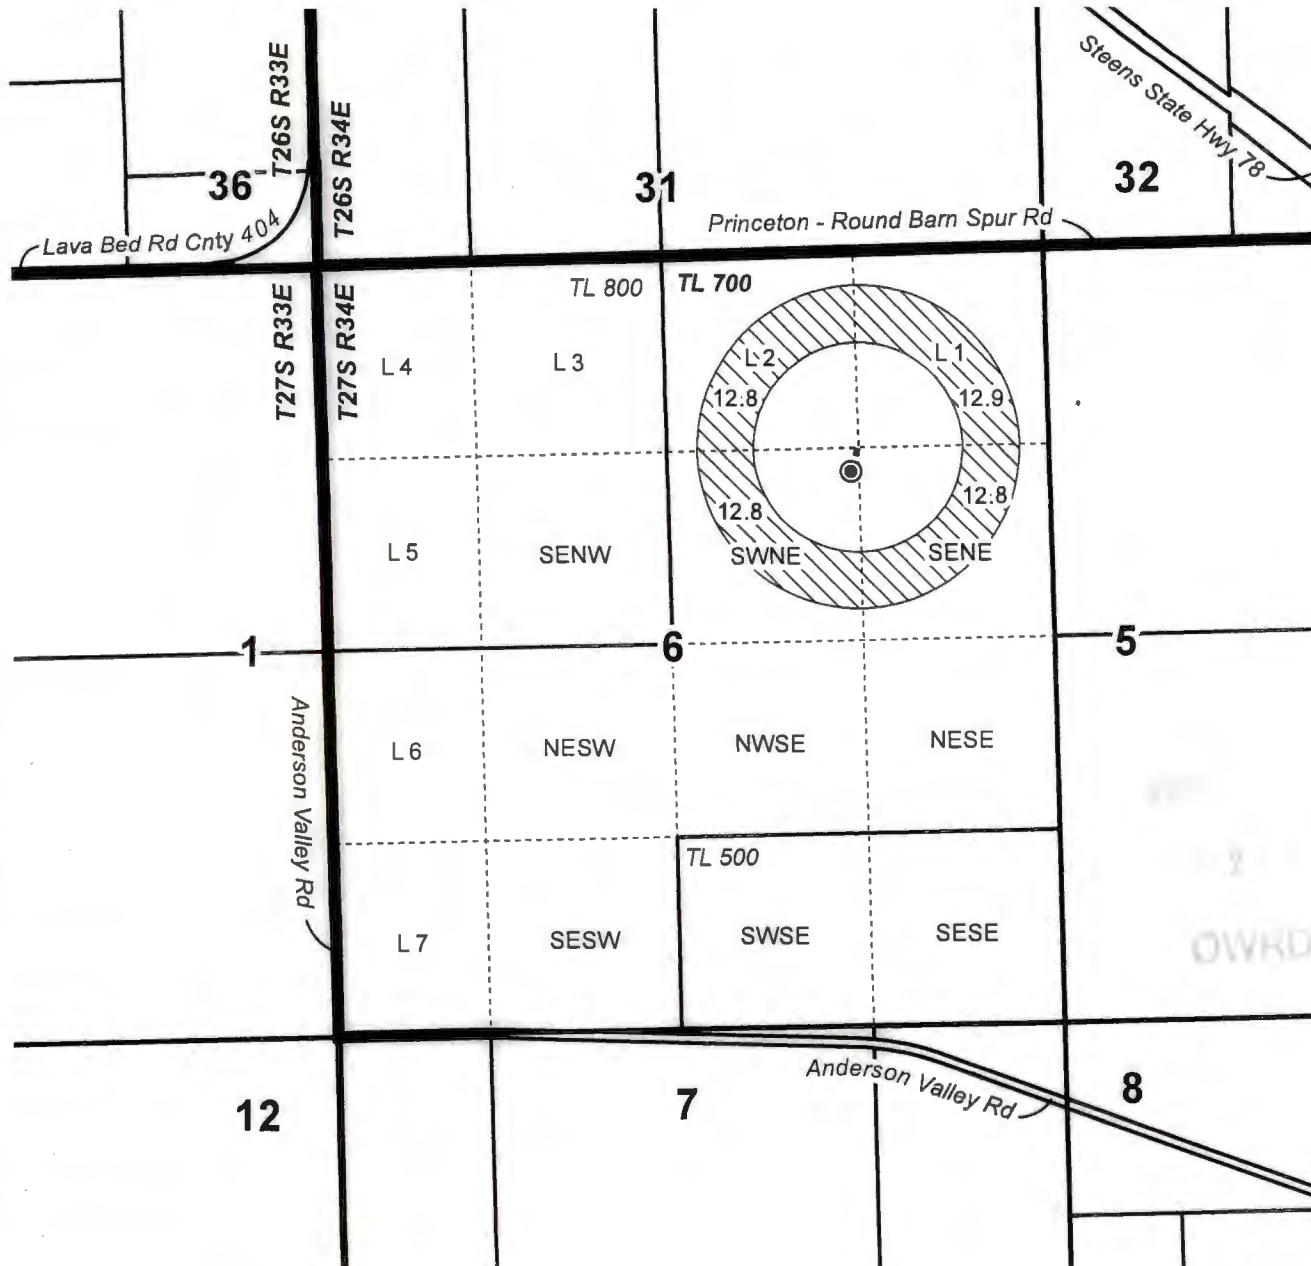

RENEWAL DATE 12/31/2021



CLAIM OF BENEFICIAL USE MAP
Golden Rule Farms, Inc.

This map is not intended
to provide legal dimensions
or locations of property
ownership lines.

WATER RIGHT SERVICES, LLC
PO BOX 1830, BEND, OR 97709
WWW.OREGONWATER.US CCB # 197121
johnshort@usa.com 541-389-2837

T-12387

Project #20059

Date: 8/28/2020