


Claim of Beneficial Use - Transfer T-12993

Eichler, Leon & Terri

This map is not intended to provide legal dimensions or locations of property ownership lines.

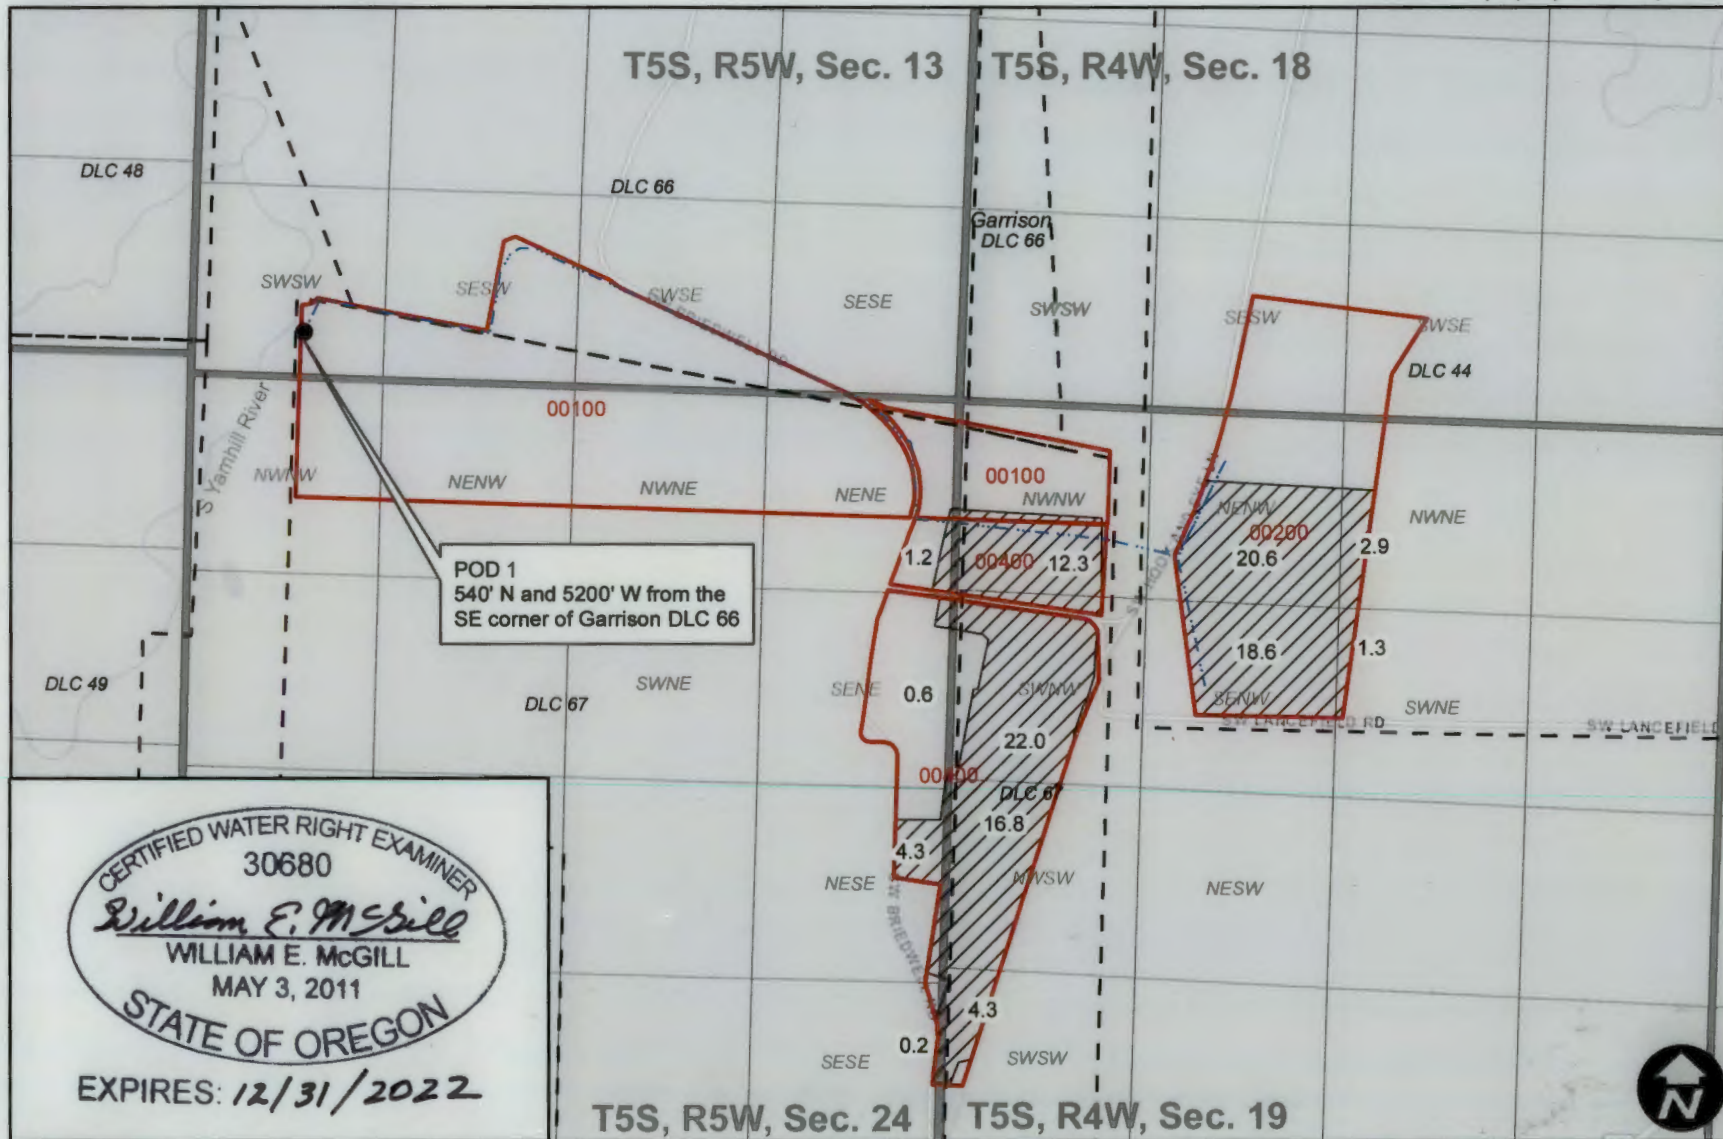


CERTIFIED WATER RIGHT EXAMINER
 30680
William E. McGill
 WILLIAM E. MCGILL
 MAY 3, 2011
 STATE OF OREGON

EXPIRES: 12/31/2022

Legend

T-12993 POU Mainline Tax Lots DLC

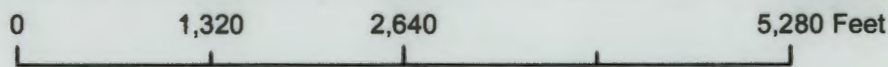

RECEIVED

FEB 11 2011