


- Legend**
- River
 - POD
 - Pipeline
 - Water Tank
 - Structures
 - Road
 - Railroad
 - Flow Arrow
 - Gov Lot
 - DLC
 - Section
 - Quarter
 - Sixteenth
 - Parcels

THE PURPOSE OF THIS MAP IS TO IDENTIFY THE LOCATION OF THE WATER RIGHT. IT IS NOT INTENDED TO PROVIDE INFORMATION RELATIVE TO THE LOCATION OF PROPERTY OWNERSHIP BOUNDARY LINES.

MAP PREPARED BY:
 NATHAN R. REED, PE, CWRE
 157 W. BODIE ST
 ROSEBURG, OR 97471

MAP PREPARED FOR:
 COW CREEK BAND of the UMPQUA INDIANS
 2371 NE STEPHENS ST.
 ROSEBURG, OR 97470

RECEIVED
 SEP 16 2019
 OWRD

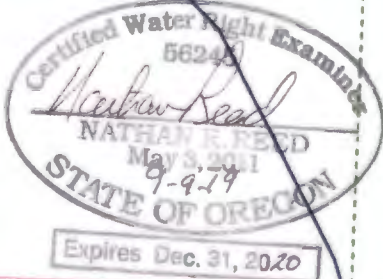

DATE SURVEYED: AUGUST 27, 2019
 POD IS LOCATED 1820 FEET NORTH AND 1620 FEET EAST FROM THE SW CORNER OF SECTION 7