


T.4S. R.1E. W.M.

CLACKAMAS COUNTY

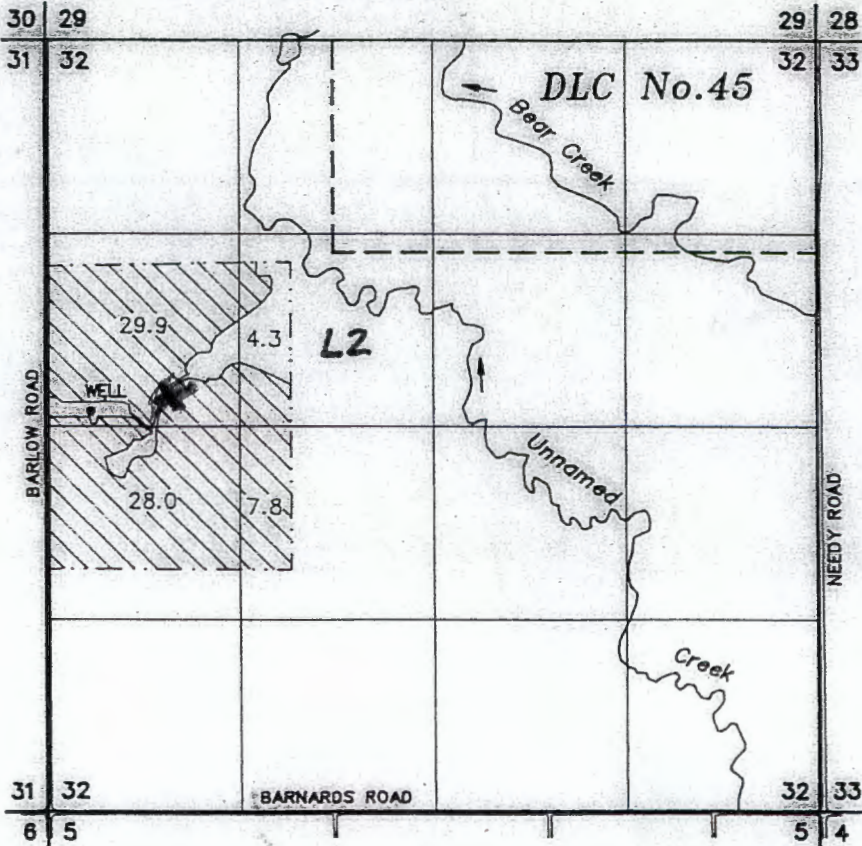

**RECEIVED**  
**DEC 01 1988**  
 WATER RESOURCES DEPT.  
 SALEM, OREGON



DIVERSION POINT: 2800' N AND 250' E OF THE SW CORNER OF SECTION 32.

Reservoir **X** 11/10/18  
**FINAL PROOF SURVEY**  
 UNDER

RECEIVED  
 NOV 16 2018  
 OWRD

Application No. G-13951 Permit No. G-13012

RECEIVED  
 DEC 03 2018  
 OWRD

**GARY R. POSTLEWAIT**

SEPTEMBER 7, 1999  
 SCALE: 1" = 1320'



NOTE: This map is for the purpose of identifying the location of water rights and has no intent to dimension or locate property ownership lines.

Gov Lot added to map 6/8/14 AC WRD