



SCALE 1" = 400'

T.35S.,R.2W.,W.M.
Jackson County, Oregon
Tax Lot No. 352W 22 - 1801 & 1802
ROGUE RIVER BASIN

LEGEND

— x — x — = Fence
- - - - - = Irrigation Risers
(22 Total)

 = IRRIGATED AREA,
PERMIT NO. G-13360


 = IRRIGATED AREA,
PERMIT NO. G-13798

WELL COORDINATES

WELL No. 1, 70' NORTH AND 360'
EAST FROM THE SOUTH
1/4 COR. SECTION 22

WELL No. 2, 70' NORTH AND 630'
EAST FROM THE SOUTH
1/4 COR. SECTION 22

WELL No. 3, 2120' NORTH AND 300'
EAST FROM THE SOUTH
1/4 COR. SECTION 22
CWRE NOTE: TIE TO WELL
NO. 3 ON APPLICATION
WAS NOT CORRECT

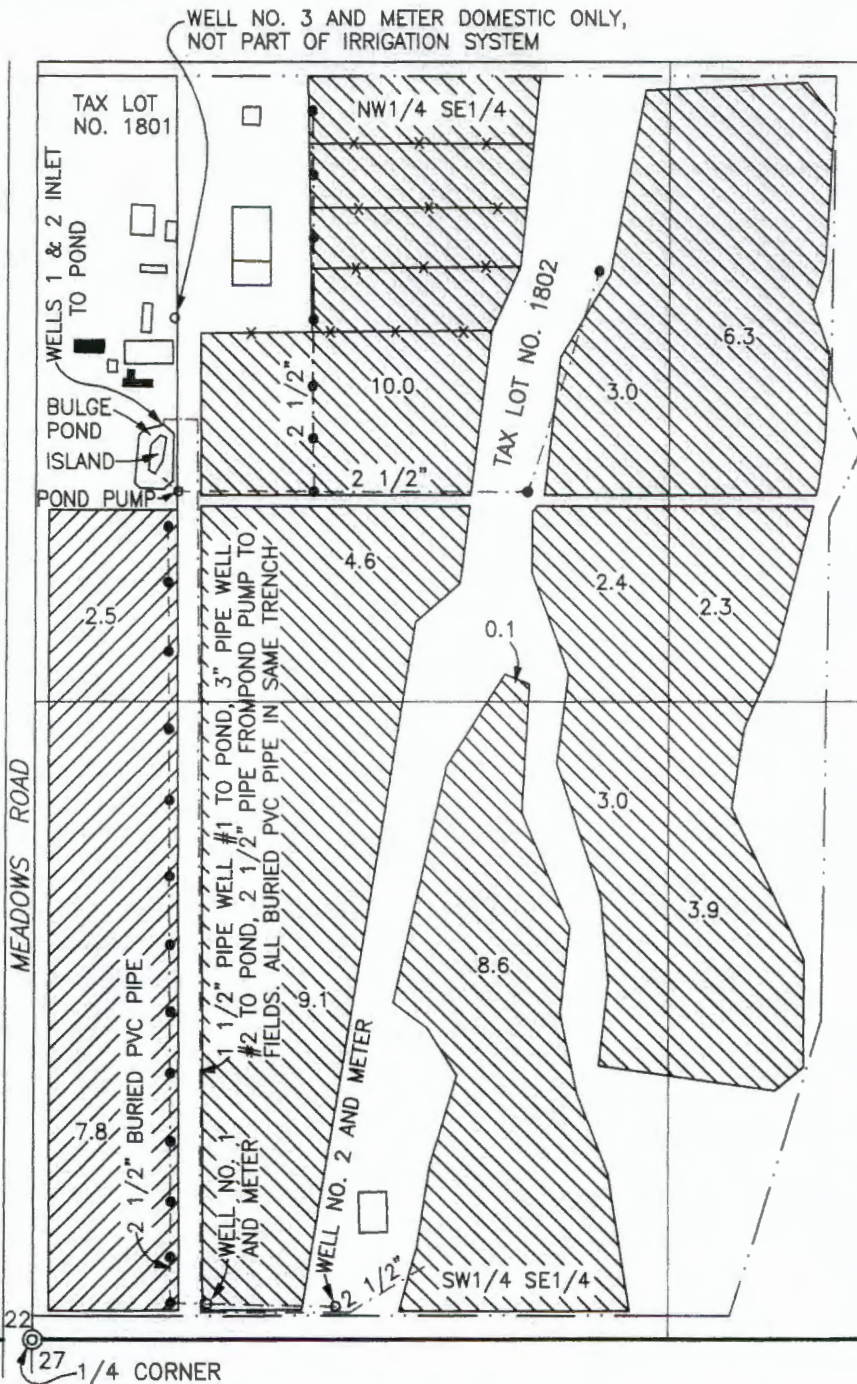


NE1/4 SE1/4

SE1/4 SE1/4

RECEIVED BY OWRD

DEC 22 2014

SALEM, OR

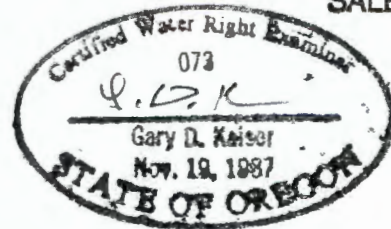

CLAIM OF BENEFICIAL USE MAP

APPLICATION No. G-14571, PERMIT
No. G-13360 AND APPLICATION No.
G-14950, PERMIT No. G-13798

FOR: JOSEPH BERTO
10984 MEADOWS ROAD
WHITE CITY, OREGON 97503

PREPARED BY:
GARY D. KAISER
19440 HWY. 62
EAGLE POINT, OR. 97524

DECEMBER 15, 2014

NOTE: MAP PREPARED FOR
WATER RIGHT PURPOSES ONLY,
NOT FOR PROPERTY BOUNDARY
LOCATIONS.