

CLAIM of BENEFICIAL USE


FOR: MARILYN GILL

BY: NATHAN R. REED, P.E., CWRE

SECTION 21, T24S, R4W, W.M., DLC 39 DOUGLAS COUNTY


APPLICATION NO. R-74927

PERMIT NO. R-12238

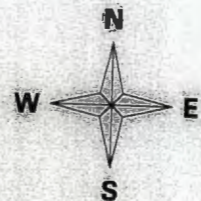

SCALE: 1" = 400'

INSPECTION DATE: MAY 6, 2018

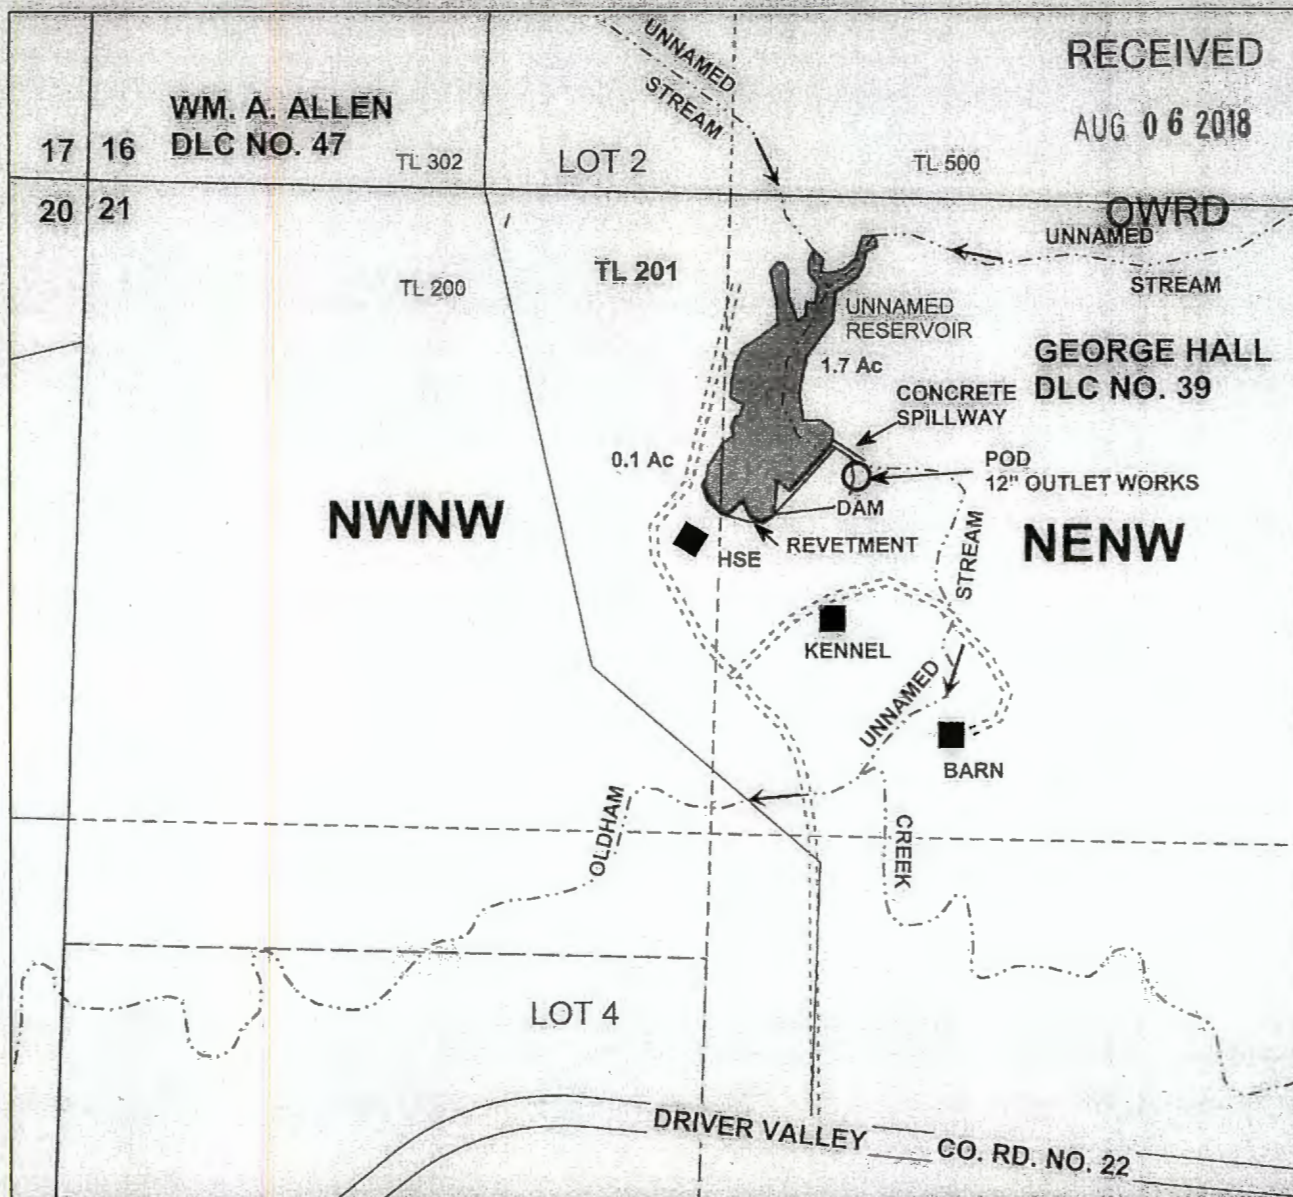

POD: 542 FEET SOUTH AND 1548 FEET EAST FROM THE NW CORNER OF SECTION 21.

Legend

○	POD	→	Flow arrow	----	Gov Lot	----	Quarter
----	Stream	----	Roads	----	DLC	----	Sixteenth
----	Dam	■	Structures	----	Section	----	Parcels
■	Reservoir						

MAP PREPARED FOR:
MARILYN GILL
6925 DRIVER VALLEY ROAD
OAKLAND, OR 97462

THE PURPOSE OF THIS MAP IS TO IDENTIFY THE LOCATION OF THE WATER RIGHT. IT IS NOT INTENDED TO PROVIDE INFORMATION RELATIVE TO THE LOCATION OF PROPERTY OWNERSHIP BOUNDARY LINES.

MAP PREPARED BY:
NATHAN R. REED, P.E., CWRE
1113 SE CASS AV
ROSEBURG, OR 97470