


T.4S. R.1E. Section 36, W.M.

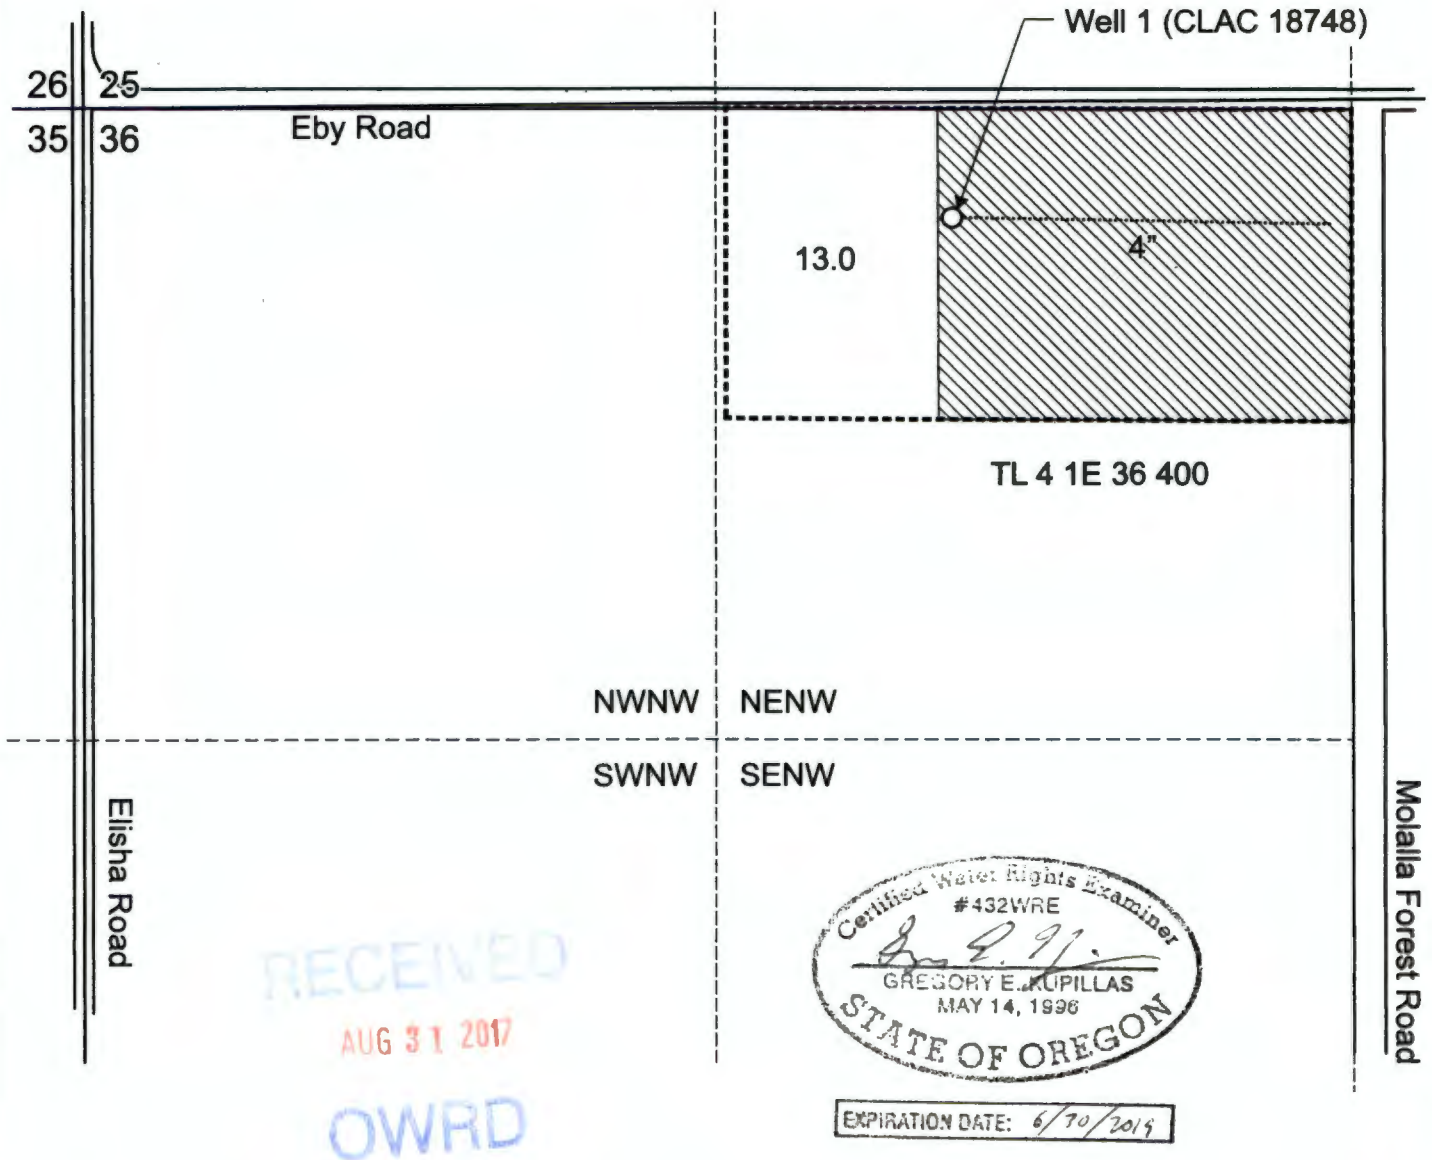

Well 1 (CLAC 18748) is located 250 feet south and 1,850 feet east from the NW Corner, Section 36.



Area (13.0 acres) irrigated under Application G-16272, Permit G-16195.




4-inch buried mainline



Tax lot boundary

Scale: 1" = 400'

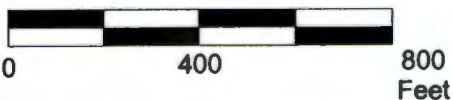

This map was prepared for the purpose of identifying the location of a water right only and is not intended to provide legal dimensions or location of property ownership lines.

Claim of Beneficial Use Map
Application G-16272, Permit G-16195

Joseph Novak
T.4S. R.1E. Section 36, W.M.

Pacific Hydro-Geology Inc.

2017-bgp