

CLAIM OF BENEFICIAL USE MAP

Legal Description: GOV'T LOT 8 IN THE NE1/4 NE1/4 OF SECTION 27, T21S, R46E, W.M.
(TAX LOT 300, MAP 21S46E27)


RECEIVED

MAR 06 2019

OWRD

LEGEND, ABBREVIATIONS

- ⊕ SECTION CORNER
- ⊗ WEIR BOX (W/ STOP BOARDS)
- PUMP & POWER METER
- POD WITH TRASH SCREEN
- SECTION & DIVISION LINE
- - - 18" HDPE PIPE EXCEPT AS NOTED
-  HIGH WATER SURFACE AREA
- I.D. INSIDE DIAMETER

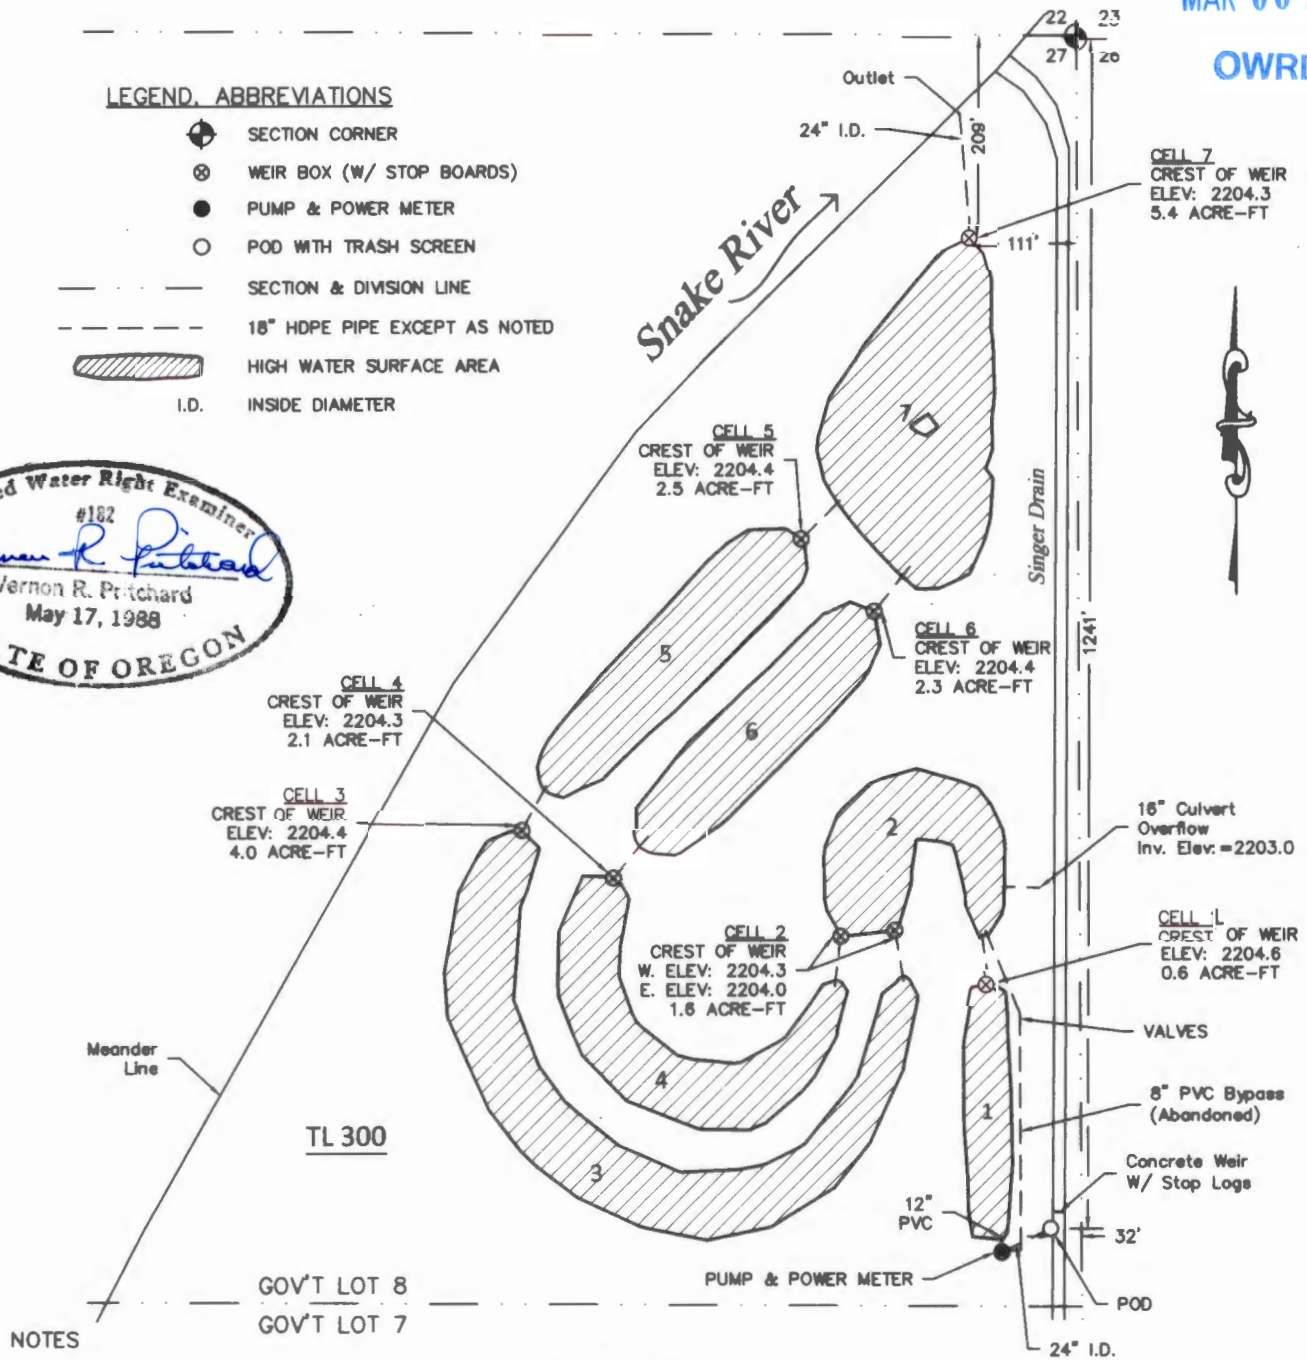

NOTES

- THIS MAP IS FOR THE PURPOSE OF LOCATING A WATER RIGHT AND IS NOT INTENDED TO PROVIDE LEGAL DIMENSIONS FOR LOCATIONS OF PROPERTY BOUNDARIES.
- DISTANCES SHOWN WERE CALCULATED FROM FIELD SURVEYS.
- SECTION 27:
TAX LOT 300-CHOIR BOYS LLC
- MAXIMUM STORAGE IS 18.5 ACRE-FT

SCALE: 1" = 200'



Application: R-86877

VERN PRITCHARD 541-473-3612
P.O. BOX 134
VALE, OR 97918

CHOIR BOYS LLC

CLAIM OF BENEFICIAL USE
APP. R-86877, PERMIT R-14538

DRAWN: D. McKROLA

SCALE: 1" = 200'

APPROVED:

DWG No. 015

DATE: MARCH 1, 2019

SHEET 1 OF 1

Permit: R-14538