


Section 10, T16S, R12W, W.M.,
Lane County, Oregon

RECEIVED

AN 11/12

OWRD

CLAIM OF BENEFICIAL USE MAP
Russell & Kristine Fowler
Application S-85351, Permit S-53959
Permit Amendment T-10631

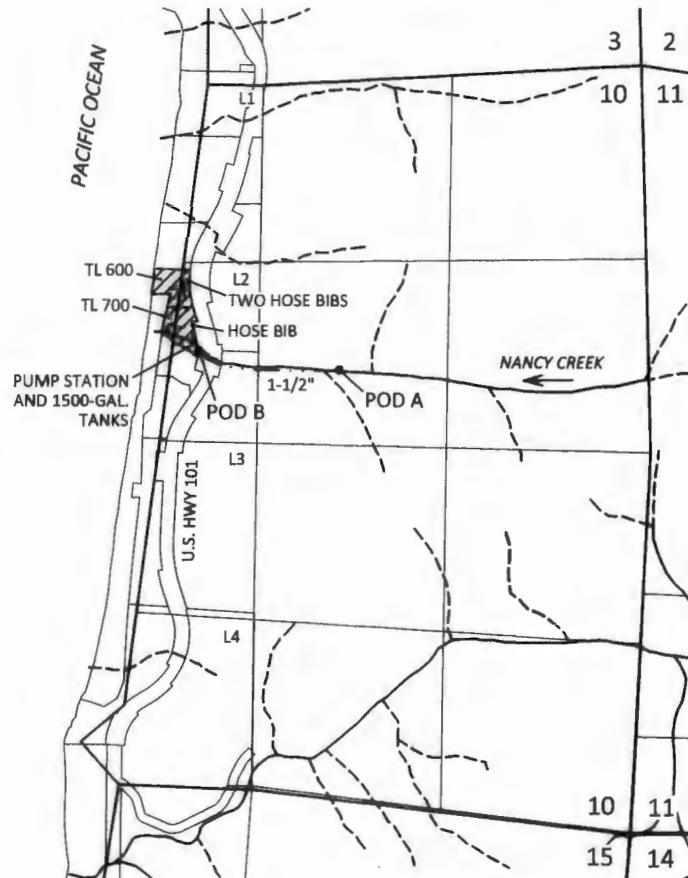

POD A LOCATION: 1940 FT S AND 530 FT E FROM NORTH 1/4 CORNER SECTION 10, T16S, R12W, W.M.


POD B LOCATION: 1810 FT S AND 430 FT W FROM NORTH 1/4 CORNER SECTION 10, T16S, R12W, W.M.



EXPLANATION

-  PLACE OF USE DOMESTIC EXPANDED FOR 2 HOUSEHOLDS
PRIORITY: 11/21/2020
-  POINT OF DIVERSION (POD)
-  1-1/2" PIPELINES

Site inspection conducted:
12/15/2020

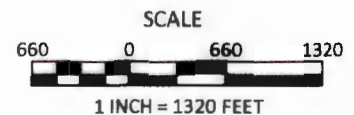

January 4, 2021

This map is not intended to provide legal
dimensions or locations of property
ownership lines

Figure 1

SKOOKUM
WATER ASSOCIATES INC

1626 VICTORIAN WAY
EUGENE, OR 97401
(503) 319-8926