


X 3872. 1/4 COR. SECTION 8

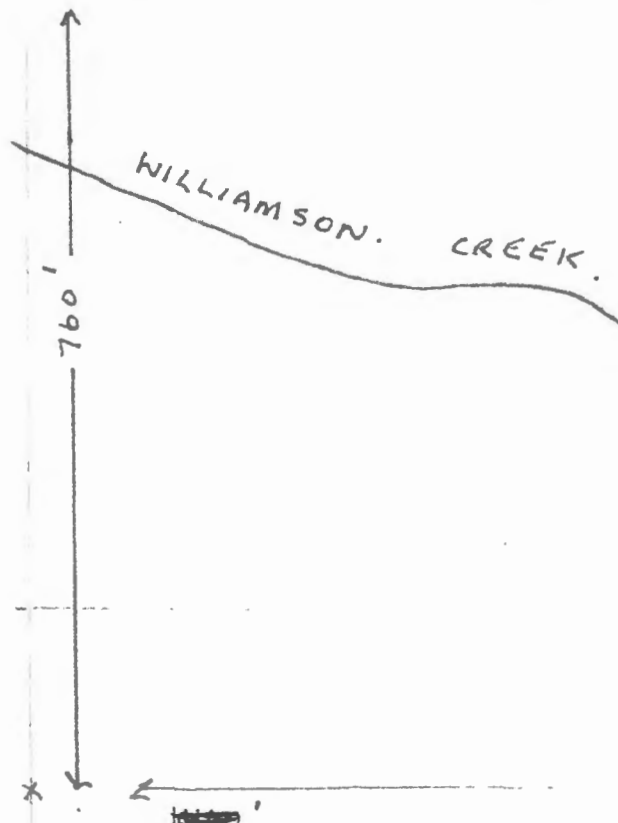

RECEIVED

MAR 31 2005

WATER RESOURCES DEPT
SALEM, OREGON


158

RECEIVED

APR 11 2005

WATER RESOURCES DEPT
SALEM, OREGON

DAM 6'
RESERVOIR
APPX. 60' x 80'
 $1382 + 320 =$

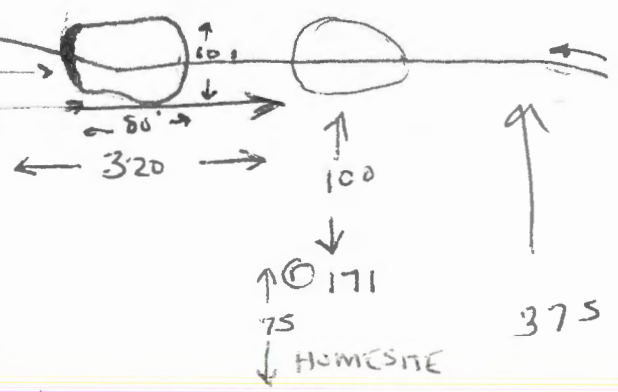

RECEIVED

AUG 14 2019

OWRD


RECEIVED

JUL 31 2019

OWRD

691

691

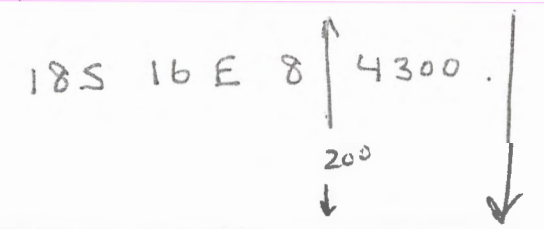

↓ 3875. $\frac{7}{18} \mid \frac{8}{17}$

1320' SOUTH

1" = 200'