


Claim of Beneficial Use for Permit S-54878 (Application S-85920) A Water Right in the Name of VFO Independence, LLC

Polk County, Oregon

Township 9 South, Range 4 West (W.M.)

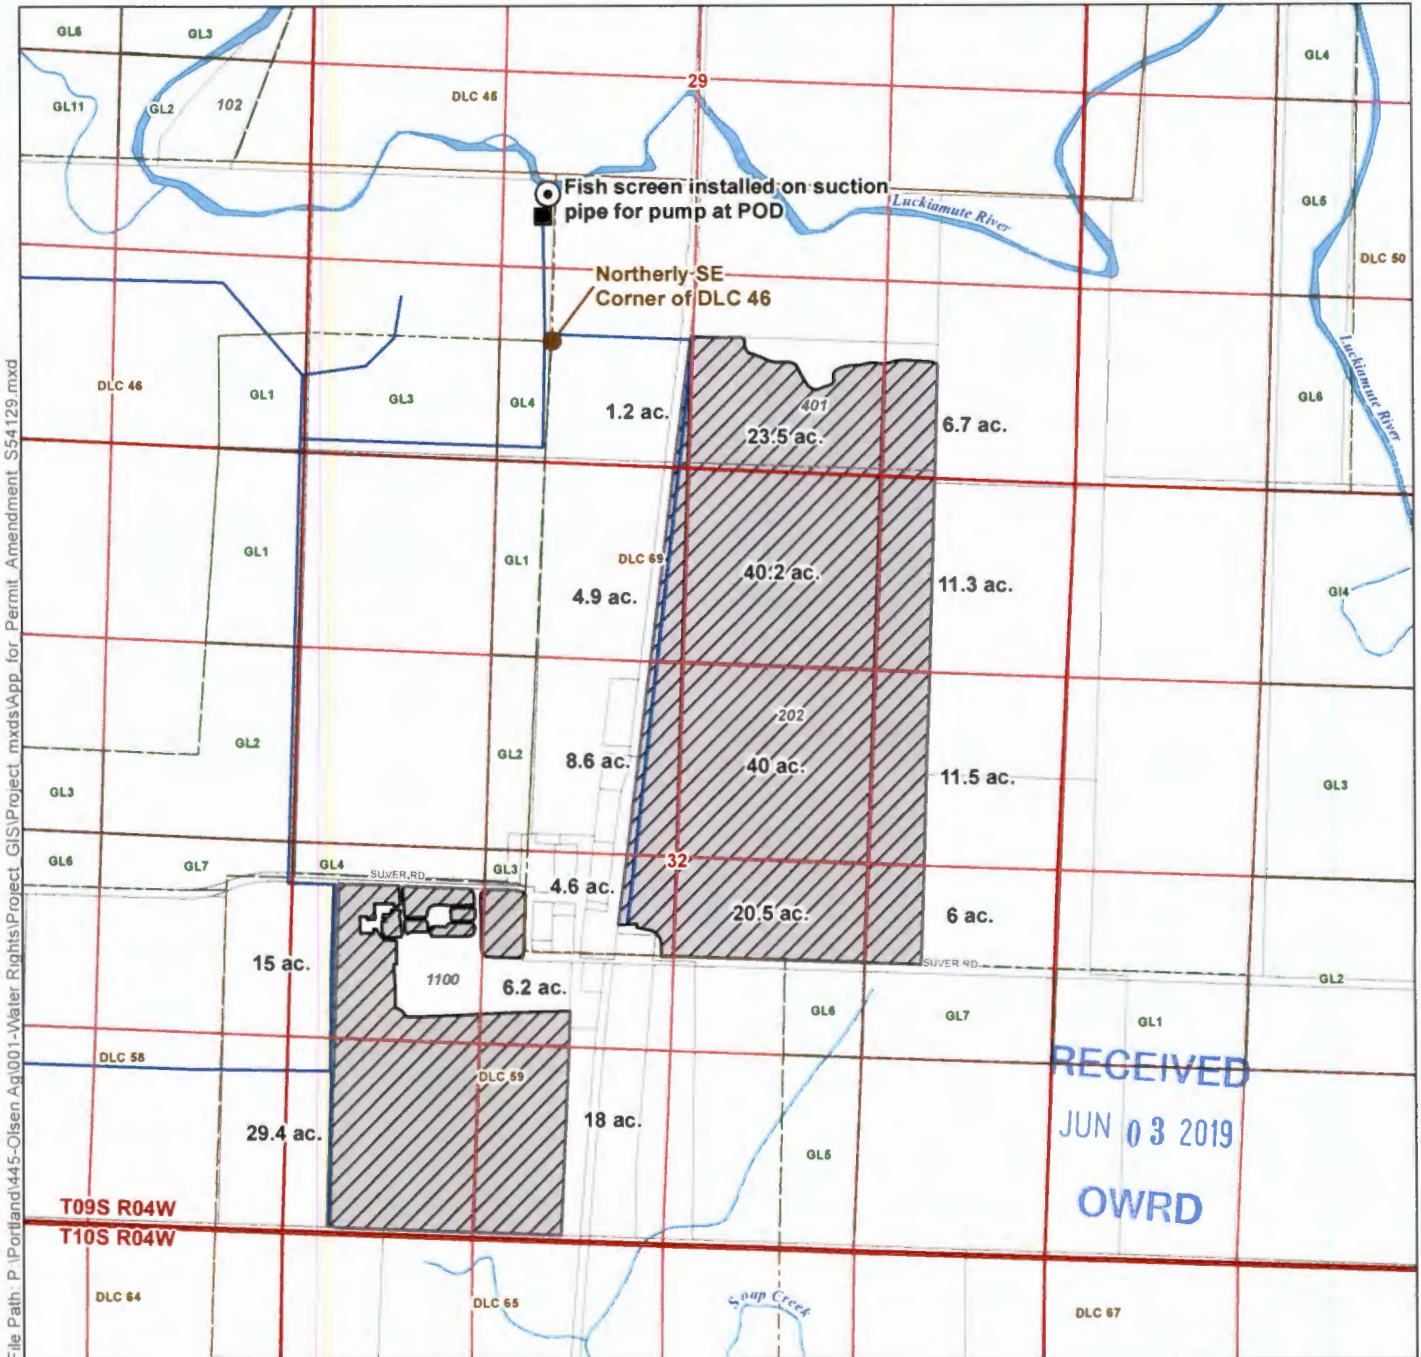

File Path: P:\Portland\445-Olsen Ag\001-Water Rights\Project_GIS\Project_mxd\App_for_Permit_Amendment_S54129.mxd

LEGEND

- ⊙ Point of Diversion (POD)
- Flow Meter
- ▨ Place of Use (POU)
- Mainline
- Government Lot (GL)
- Donation Land Claim (DLC)

- All Other Features**
- Tax Lot
 - ~ Watercourse
 - ~ Waterbody

Certified Water Rights Examiner Stamp



DISCLAIMER

This map was prepared for the purpose of identifying the location of a water right only and it is not intended to provide legal dimensions or location of property ownership lines.

MAP NOTES

Date: December 20, 2018
Data Sources: OWRD, Polk Co., Benton Co., BLM, USGS

POD LOCATION DESCRIPTION

Point of Diversion
1,010 feet North and 58 feet West from Northerly SE Corner of DLC 46 (NESE), Township 9 South, Range 4 West (W.M.)

