


TOWNSHIP 17 SOUTH, RANGE 5 WEST, W.M.

TAX MAP NO. 17-05-25-00

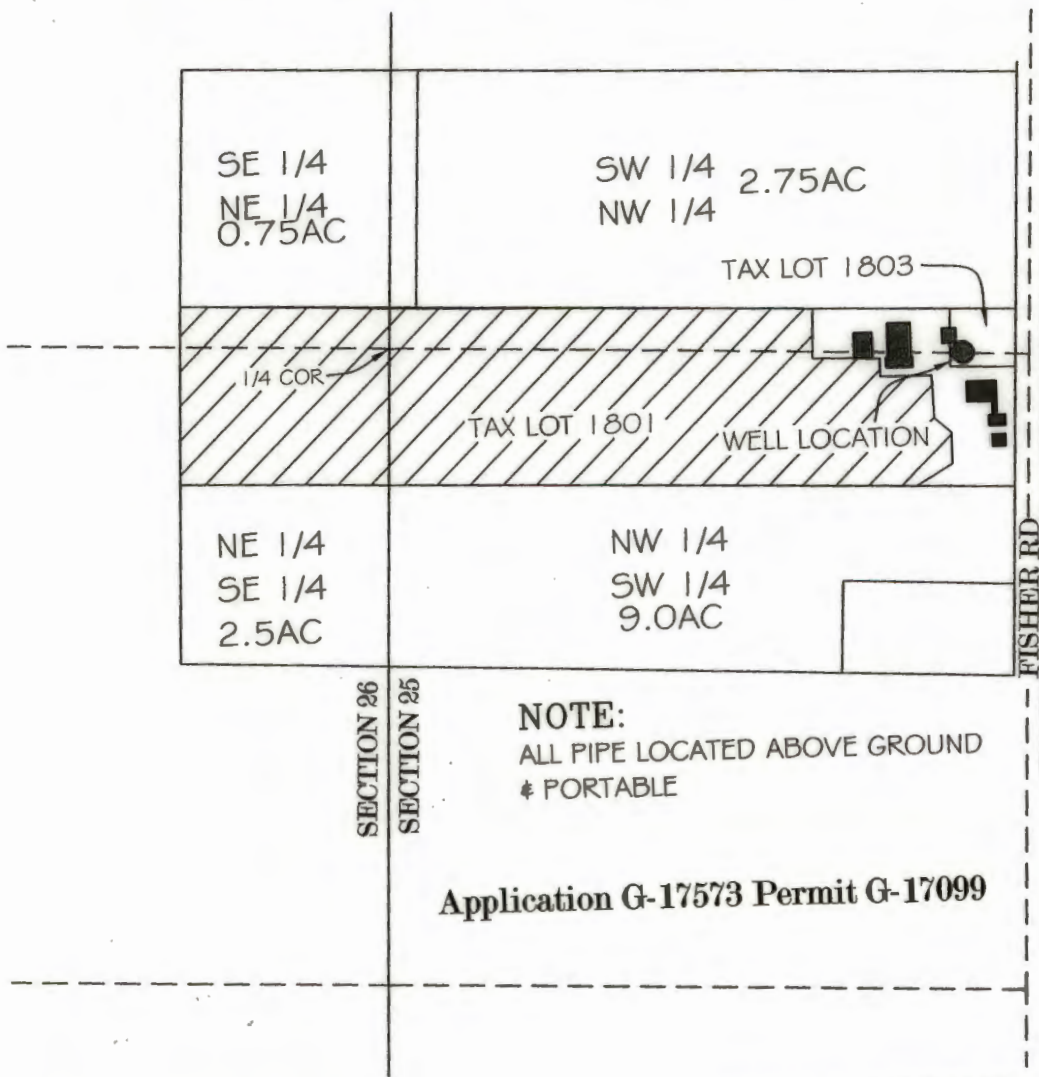




RECEIVED
APR 01 2019
OWRD



NOTE:
ALL PIPE LOCATED ABOVE GROUND
& PORTABLE

Application G-17573 Permit G-17099

-  DENOTES AREA OF BENEFICIAL USE
-  WELL
WELL ID LANE G3542, L-64796
NORTH 38.7 FT & EAST 1186.4 FT
FROM WEST 1/4 COR. SEC. 25.
FLOW METER LOCATED AT WELL
-  DENOTES BUILDING LOCATION

NOTE
THIS MAP WAS PREPARED FOR THE PURPOSE OF IDENTIFYING THE LOCATION OF THE WATER RIGHT ONLY. IT IS NOT INTENDED TO PROVIDE DIMENSIONS OR LOCATION OF PROPERTY OWNERSHIP LINES.

FINAL PROOF SURVEY
for
Ridgeview Alpaca Farm
Wally Gresl & Jackie Lucas
88520 Fisher Rd
Eugene, OR 974025

by
H. Timothy Fassbender, PLS, CWRE
2896 Sarah Lane
Eugene, OR 97408
January 28, 2019

