


# Claim of Beneficial Use for Permit S-54879 (Application S-85920) A Water Right in the Name of VFO Independence, LLC

Polk County, Oregon


Township 9 South, Range 4 West (W.M.)

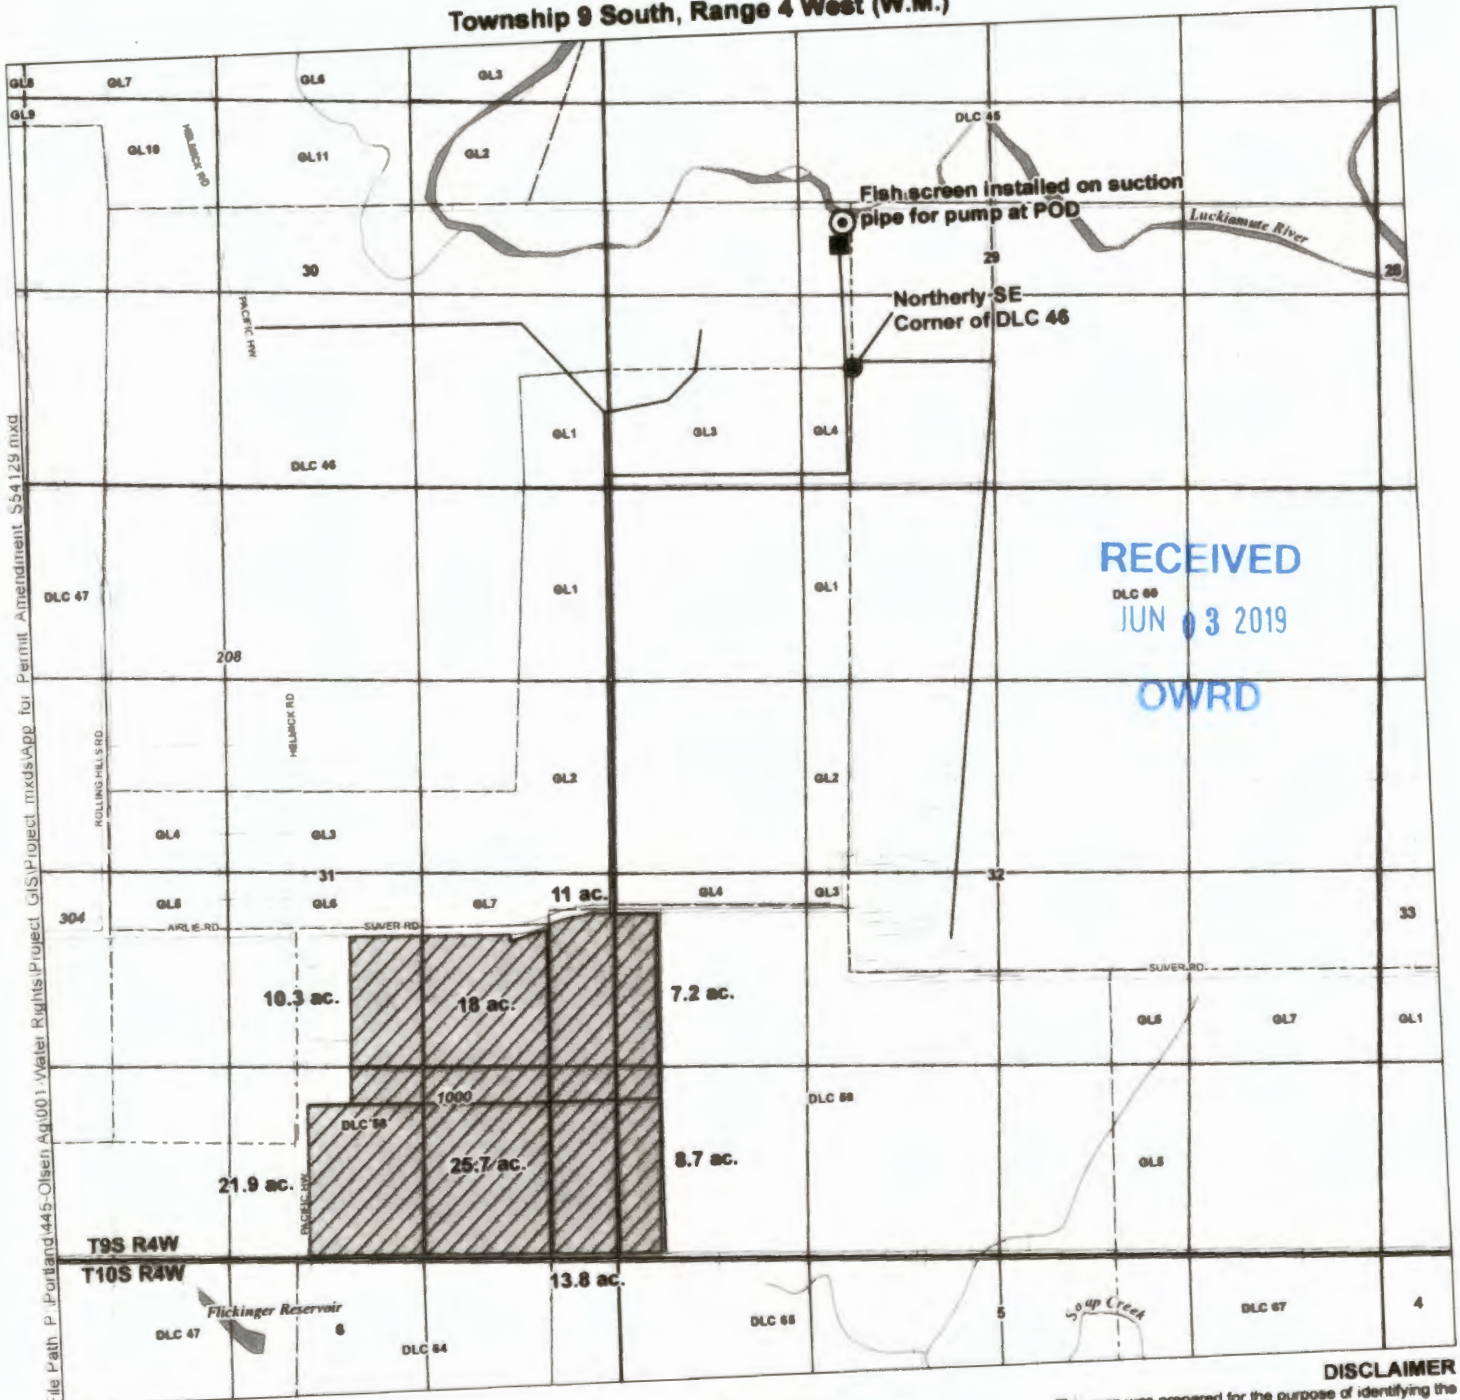

File Path: P:\Portland\445-Olsen\Ag\001-Water Rights\Project\_GIS\Project\_mxd\app\_for\_Permit\_Amendment\_S54129.mxd

- LEGEND**
- Point of Diversion (POD)
  - Flow Meter
  - Place of Use (POU)
  - Mainline
  - Government Lot (GL)
  - Donation Land Claim (DLC)

- All Other Features**
- Tax Lot
  - Watercourse
  - Waterbody

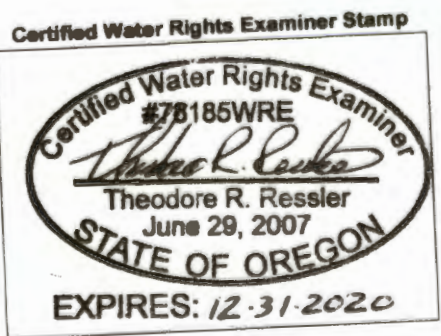

**DISCLAIMER**  
This map was prepared for the purpose of identifying the location of a water right only and it is not intended to provide legal dimensions or location of property ownership lines

**MAP NOTES**  
Date: January 23, 2019  
Data Sources: OWRD, Polk Co., Benton Co., BLM, USGS

**POD LOCATION DESCRIPTION**  
Point of Diversion  
1 010 feet North and 58 feet West from Northernly SE Corner of DLC 46 (NEBE), Township 9 South, Range 4 West (W.M.)

