P:\23\23613001\CAD\00\Water Rights Support\2361300100_Final Proof Survey Map.dwg TAB:Survey Map Date Exported: 10/19/18 - 14:19 by hmara

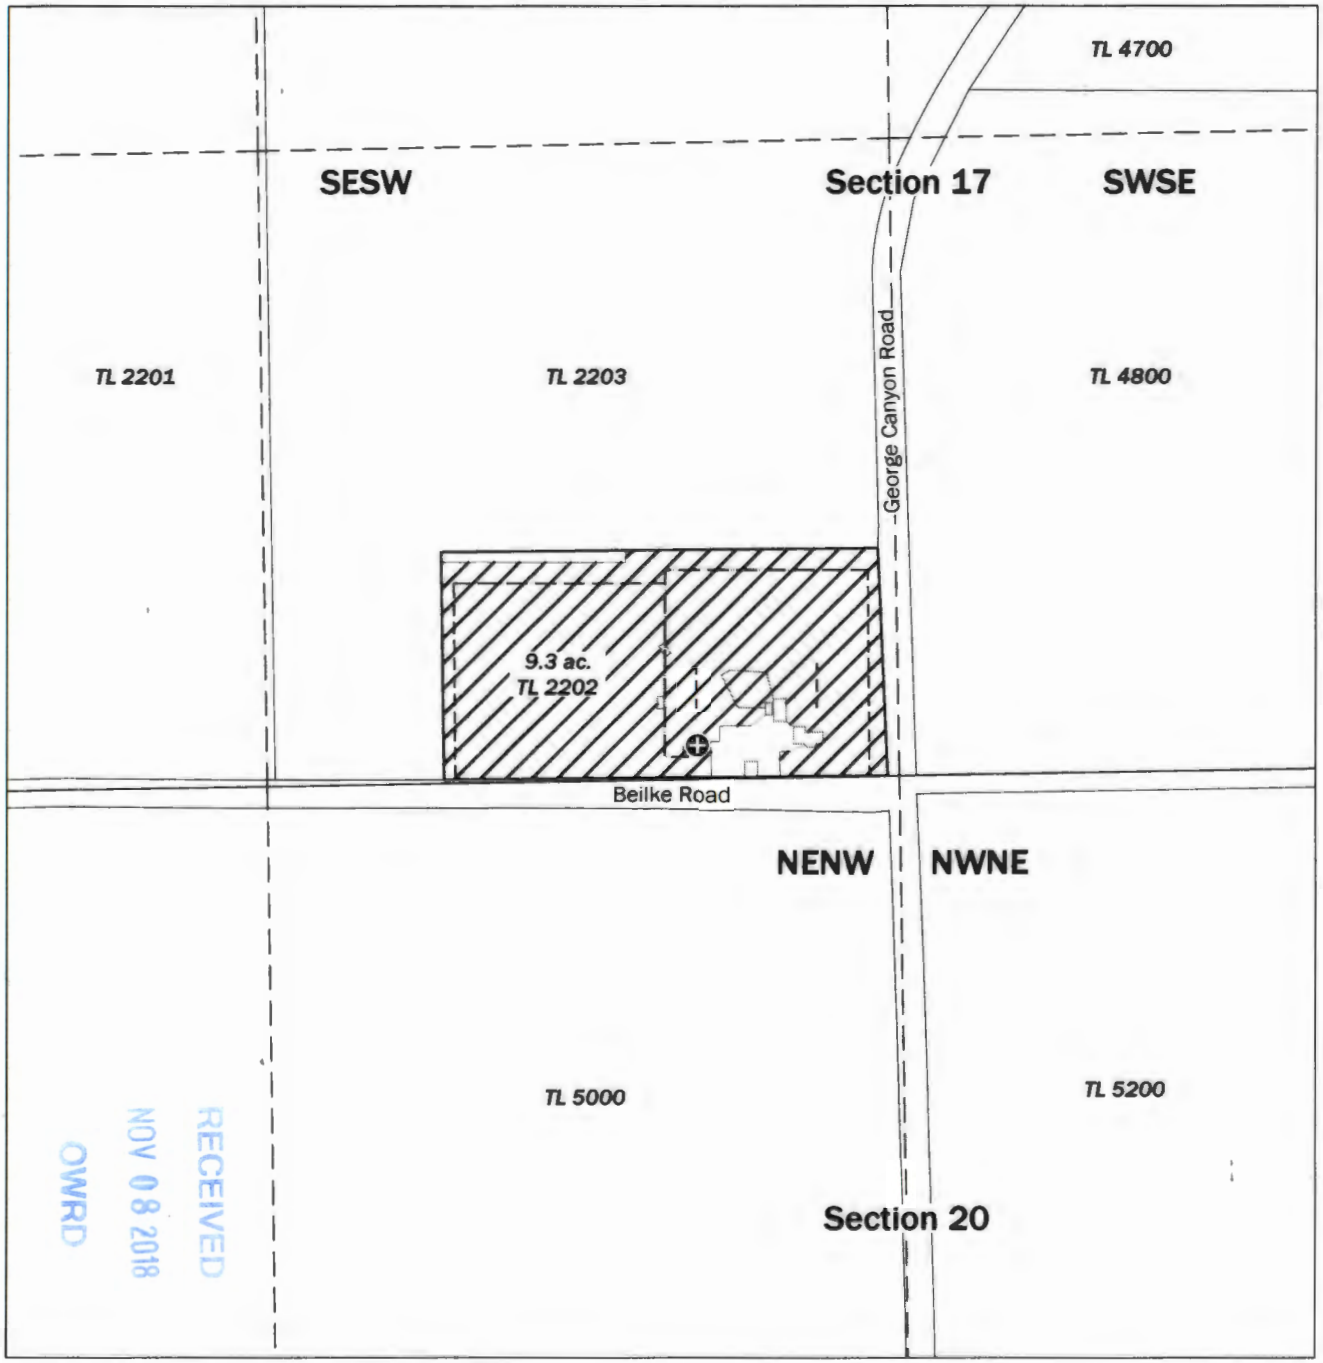

Final Proof Survey Map
for G. Dubois
Ap # G-17682, Permit # G-17136

T1N, R32E, W.M.
Section 17
SE 1/4, SW 1/4
Umatilla County, Oregon

Legend

- New Well and Flowmeter
- Property Boundary Line
- Buried Main Line
- Wheel Line
- Irrigated Area

Well Location

New Well

Located 71 feet North and 419 feet West from the S 1/4 corner, section 17 T1N R32E, W.M.

Certified Water Rights Examiner Stamp

CERTIFIED WATER RIGHTS EXAMINER
93136CWRE
JONATHAN S. TRAVIS
JUNE 3, 2016
STATE OF OREGON

EXPIRES: 6/30/2020

N
W E
S

400 0 400
Feet

Disclaimer

This map was prepared for the purpose of identifying the location of a water right only and it is not intended to provide legal dimensions or location of property ownership lines.

Map Notes

Date: 10/9/2018
Data Sources: ESRI
Prepared By: GeoEngineers

GeoEngineers

RECEIVED
NOV 08 2018
OWRD