

Claim of Beneficial Use Map for T-10794

T 38 S, R 8 W, WM, Josephine County

Portions of Sections 9, 10, and 11

July 26, 2018

Map 3 of 3

RECEIVED

JUL 30 2018


OWRD

N

1" = 1320'



7-26-2018
exp 12-31-2018

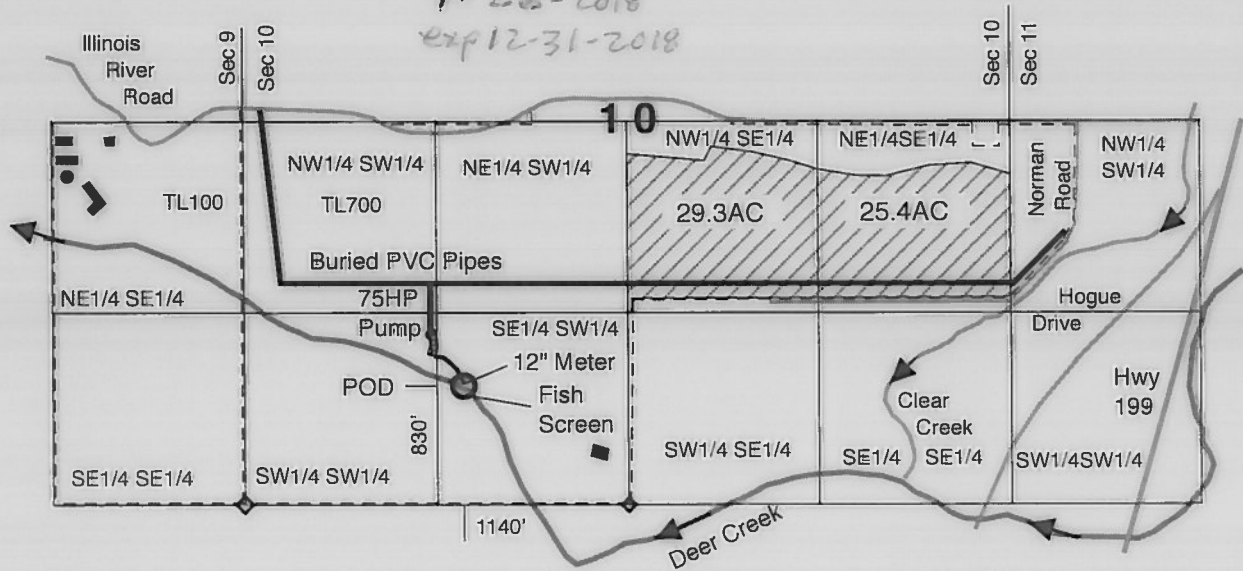

From Illinois River Decree, and Certificate #13831 with a priority of 1885 for irrigation at a rate of 1/50 cfs per acre plus an additional 0.0104 cfs per acre with a priority of July 7, 1932 from Deer Creek.

○ POD located 1140 feet west and 830 feet north from the S1/4 corner of section 10.

▨ 54.7 acres of primary irrigation rights from C #13831.

▤ Streams and pool

■ Buildings

— Roads

- - - Tax lots

This map was drawn by Gordon R. Lyford for the Siskiyou Field Institute to support their Claim of Beneficial Use under T-10794. The SFI owns tax lots 100 and 700.

This map was prepared for the purpose of identifying the location of water rights only and is not intended to provide legal dimensions or the location of property ownership lines.