


TOWNSHIP 14 SOUTH, RANGE 6 WEST, W.M.
TAX MAP NO. 14614

RECEIVED

APR 01 2019

OWRD

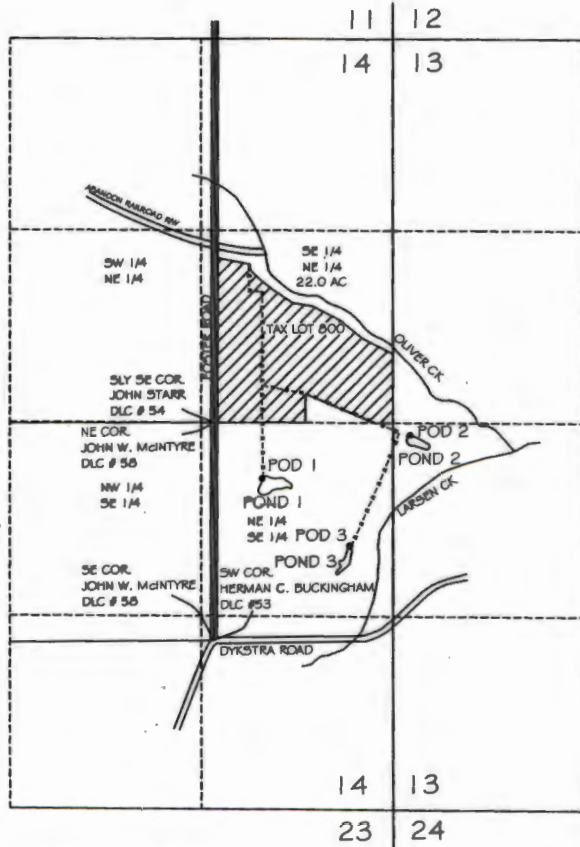

NOTE

POND WATER IS SUPPLIED VIA SURFACE RUNOFF ONLY. NO DITCH, CREEK OR STREAM LEADS INTO OR OUT OF ANY OF THE 3 PONDS.

APPLICATION S-88122

PERMIT S-54975

LEGEND

- POD #1 N17°14'43"E 1147 FT FROM SW COR. BUCKINGHAM DLC #53
- POD #2 N44°30'10"E 1934 FT FROM SW COR. BUCKINGHAM DLC #53
- POD #3 N55°50'00"E 1128 FT FROM SW COR. BUCKINGHAM DLC #53

----- DENOTES MAINLINE BURIED LOCATION



DENOTES AREA OF BENEFICIAL USE

NOTE

FISH SCREEN ATTACHED TO PORTABLE PUMP STATION & MOVED TO EACH POINT OF DIVERSION AS SHOWN HEREON. FLOW METER ALSO ATTACHED TO PUMP STATION

THIS MAP WAS PREPARED FOR THE PURPOSE OF IDENTIFYING THE LOCATION OF THE WATER RIGHT ONLY. IT IS NOT INTENDED TO PROVIDE DIMENSIONS OR LOCATION OF PROPERTY OWNERSHIP LINES.

FINAL PROOF SURVEY
FOR

MARK & MECHELE POORMAN
26293 FOSTER ROAD
MONROE, OR. 97456
BY

H. TIMOTHY FASSBENDER, PLS, CWRE
2896 SARAH LANE
EUGENE, OR. 97408
MARCH 1, 2019

