


T. 7S. R1W., W.M.

DAVID H. LEONARD

SECTION 21
MARION COUNTY
2325 EGAN ROAD
SILVERTON, OREGON 97381

PREPARATION OF THIS MAP IS FOR
THE PURPOSE OF IDENTIFYING THE
LOCATION OF THE WATER RIGHT
ONLY. THERE IS NO INTENT TO
PROVIDE DIMENSIONS OR LOCATION
OF PROPERTY OWNERSHIP LINES.

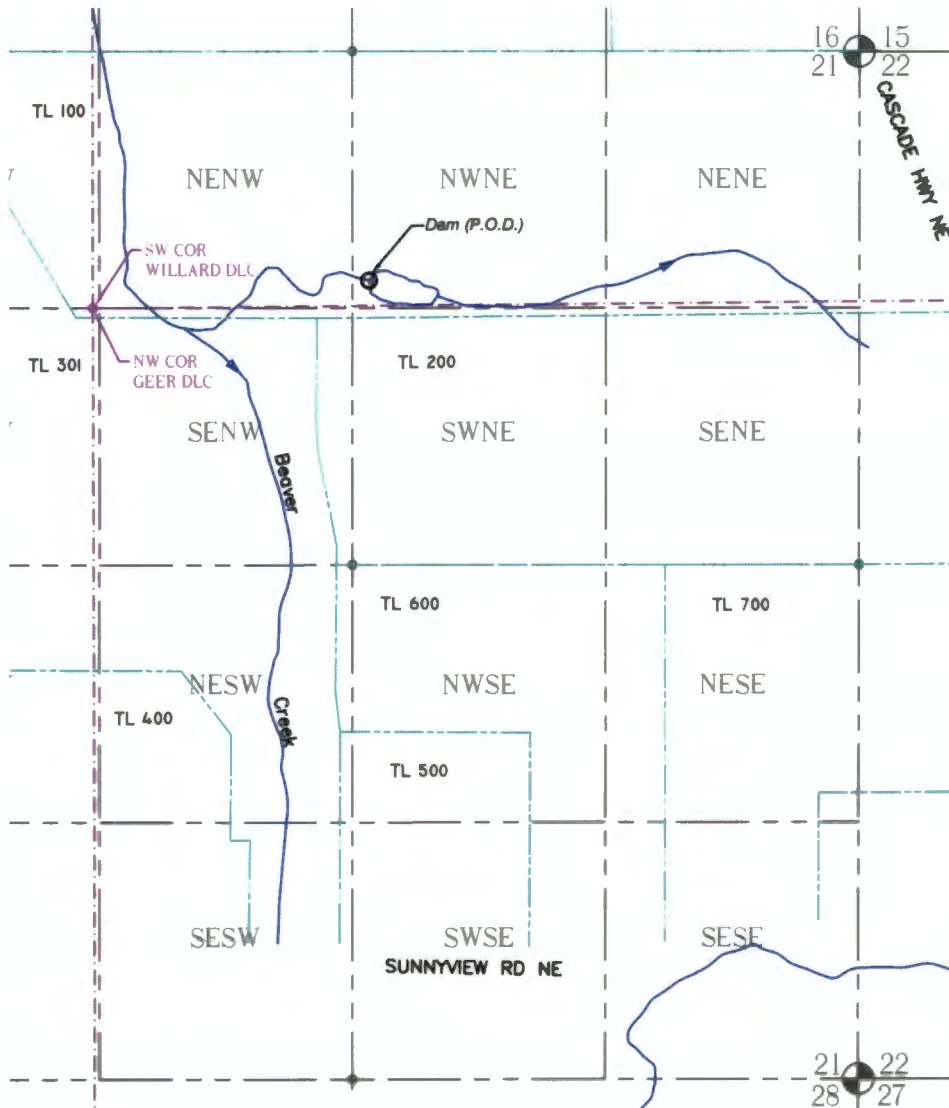

SCALE: 1"=1000'

LEGEND

- USGS GRID
- DLC BOUNDARY
- ROADWAY
- PROPERTY LINE
- STRUCTURE
- SECTION CORNER
- 1/4-1/4 CORNER
- DLC CORNER
- DAM (P.O.D.)

NOTES:

DAM (P.O.D.) IS LOCATED
1200 FT SOUTH AND
2560 FT WEST
FROM THE NE CORNER
OF SECTION 21

Survey
AND CLAIM OF BENEFICIAL USE
IN THE NAME OF DAVID H. LEONARD

FILE PATH & NAME: C:\BK Water Right Consulting\Projects\Dave Leonard\LEONARD COBU Map 112717 - wef.dwg

BK WATER RIGHT CONSULTING
PO Box 13434 Salem, Oregon 97309

Leonard COBU

APPLICATION#: R-86853 PERMIT#: R-14536 AMENDMENT#: X-XXXXX

SHEET 1 OF 1